IREDELL COUNTY HEALTH DEPARTMENT

STATESVILLE 704-878-5305 MOORESVILLE 704-664-5281

IMPROVEMENT PERMIT / CERTIFICATE OF COMPLETION / OPERATION PERMIT / EXISTING SYSTEM INSPECTION

PROPERTY DESCRIPTION NO 26280 06574 DATE 3-28-97 TAX MAP NO.

OWNER OR CONTRACTOR John M. Wallace PHONE: Business Home 294-1937 Watershed: ☐ Yes ☐ No W&IV PA

ADDRESS 1306 Courtney Dr Hickory NC

LOCATION I-40 W Old Mtn Rd TR Mackmill (Bear Left) lot across from shady Rest Rd on left

SUBDIVISION BLOCK / SECTION LOT #3 LOT AREA SITE CLASS. P/S DESIGN FLOW 360 L.T.A.R. 0.3

Septic Tank: 1000 Gallons; STB 1212 Date 3-28-97

Pump Tank: Gallons; PT Date

Pump Make: Model Serial No.

Nitrification Field: No Fields 1 Square Feet 900 Linear Feet 300

No Lines 4 Trench Width 36in Max Trench Bottom Depth 36in Gravel Depth Sand

☒ New System ☐ Repair System Type: I, II, (III) IV, V, VI

System Description: Gravity Chambers

Repair System Description: Pump "

Maintenance Agreement Required: ☐ Yes ☒ No

☒ House/Mod. Home No. Bedrooms 3

☐ Mobile Home No. Bathrooms 2

☐ Business No. Employees

☐ Other


☐ Slab ☒ Crawl Space ☐ Basement w/plumbing ☐ Basement wo/plumbing

Water Supply: ☐ Individual ☐ Community ☒ Public


Comments: keep lines on contour 9ft on center

Comments:

INITIAL SITE SKETCH

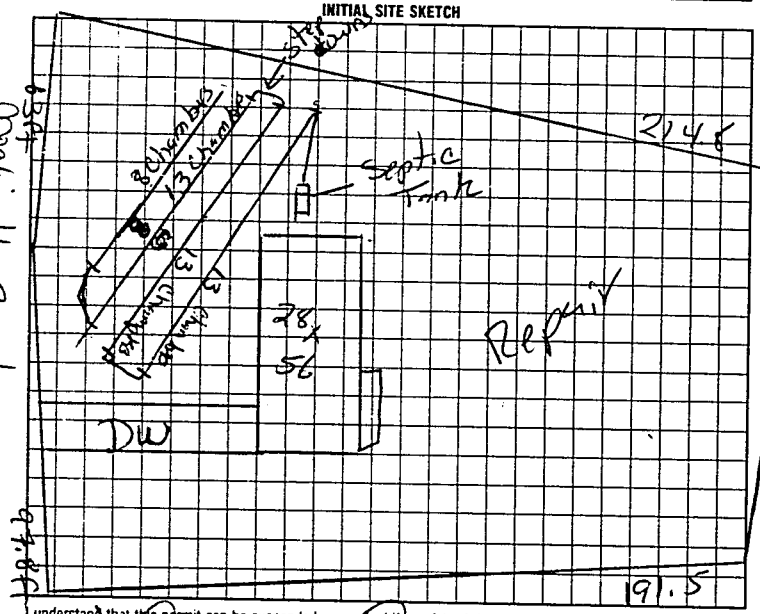

AS BUILT SKETCH

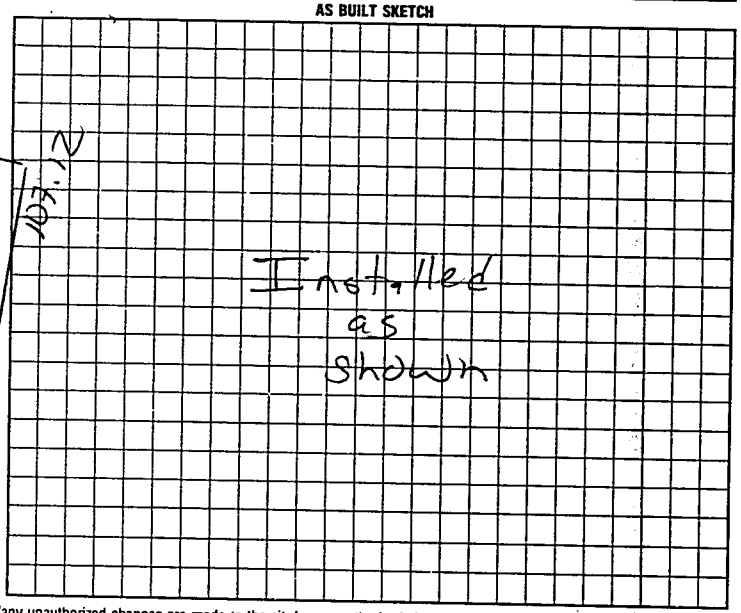

I understand that this permit can be suspended or revoked if any false information is supplied toward securing the permit/any unauthorized changes are made to the site/any unauthorized changes are made in the installation of the system. Improvement Permit is valid for 60 months from date of issuance. Authorization to construct expires 5yrs from issue date

Signed: John M. Wallace

Improvement Permit by: Authorization to const Mark C. Oaks date 3-31-97

Existing System Inspection by: Mark C. Oaks date 3-31-97

Installed by: Forest Shuford

Certificate of Completion by: date

Operation Permit by: Mark C. Oaks date 10-16-97

HEALTH DEPT. COPY WHITE | INSPECTION COPY (FINAL) GREEN | OWNER COPY (FINAL) YELLOW | INSPECTION COPY (INITIAL) PINK | OWNER COPY (INITIAL) GOLD