IREDELL COUNTY HEALTH DEPARTMENT

STATESVILLE 704-878-5305 MOORESVILLE 704-664-5281

IMPROVEMENT PERMIT / AUTHORIZATION TO CONSTRUCT / OPERATION PERMIT / EXISTING SYSTEM INSPECTION

PERMIT# 13920 PIN# 4703 10 4576 DATE 6-24-98

OWNER OR CONTRACTOR Patricia Teastey PHONE: Business _____ Home 871 4005

ADDRESS 119 Brawley Pk Dr. Sta

LOCATION 70 W TL (Wind Forest at Fork Stay left Go to cut

SUBDIVISION Wind Forest BLOCK / SECTION _____ LOT 26A LOT AREA 2.07 acres SITE CLASS. PS DESIGN FLOW 240 L.T.A.R. .33

Septic Tank: 1000 Gallons; STB 1012 Date 5-7-99

Pump Tank: _____ Gallons; PT _____ Date _____

Pump Make: _____ Model _____ Serial No. _____

Nitrification Field: No Fields 1 Square Feet 720 Linear Feet 240

No Lines 3 Trench Width 36" Max Trench Bottom Depth 36" Gravel Depth 12"

☐ New System ☐ Repair System Type: I, II, III, IV, V, VI

System Description: Conv. Gravity

Repair System Description: " "

Maintenance Agreement Required: ☐ Yes ☐ No

☐ House/Mod. Home No. Bedrooms 2

☐ Mobile Home No. Bathrooms 2

☐ Business No. Employees _____

☐ Other _____

☐ Slab ☐ Crawl Space ☐ Basement w/plumbing ☐ Basement wo/plumbing


Water Supply: ☑ Individual ☐ Public ☐ Community

Comments:/Conditions:


Comments:/Conditions:

Note: Hit Large Rock lower line

INITIAL SITE SKETCH

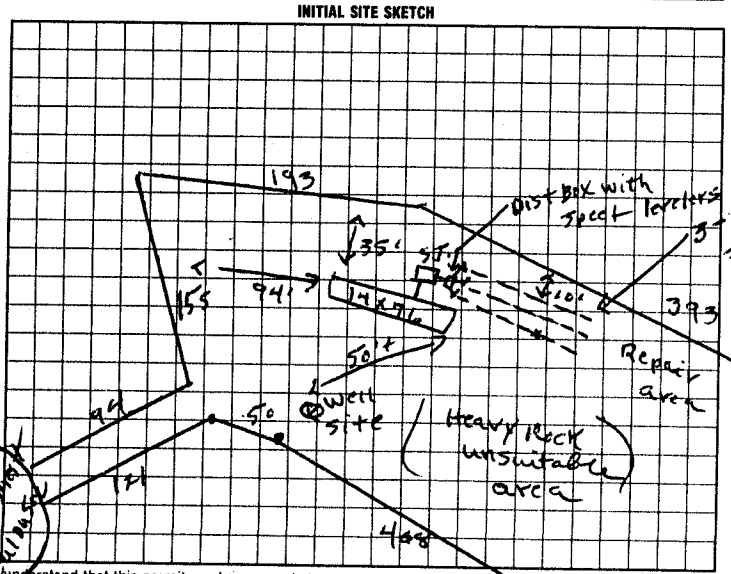

AS BUILT SKETCH

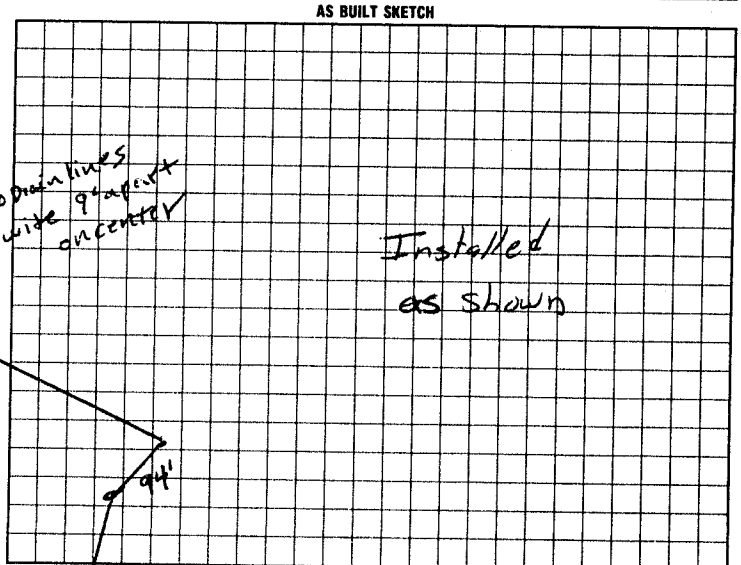

I understand that this permit can be suspended or revoked if any false information is supplied toward securing the permit/any unauthorized changes are made to the site/any unauthorized changes are made in the installation of the system. Improvement Permit with plat valid without expiration. Improvement Permit with site plan valid for sixty months. Authorization to Construct is valid for a period equal to that of Improvement Permit – not to exceed sixty months.

Signed: Laurina E Pruitte date _____ Installed by: Tommy Cothern

Improvement Permit by: P. C. Moore date 6-24-98 Operation Permit by: Mary C Outlaw REHS date 7-1-99

Authorization to Construct by: P. C. Moore date 6-24-98 Existing System Inspection by: _____ date _____

HEALTH DEPT. COPY: WHITE INSPECTION COPY (FINAL): GREEN OWNER COPY (FINAL): YELLOW INSPECTION COPY (INITIAL): PINK OWNER COPY (INITIAL): GOLD