IREDELL COUNTY HEALTH DEPARTMENT

STATESVILLE 704-878-5305 MOORESVILLE 704-664-5281

IMPROVEMENT PERMIT / AUTHORIZATION TO CONSTRUCT / OPERATION PERMIT / EXISTING SYSTEM INSPECTION

PERMIT# 071394 PIN# 3792268055 (PT) DATE 8/26/98

OWNER OR CONTRACTOR Peeks Inc PHONE: Business (704) 561-9536 Home

ADDRESS 4201 Monroe Rd Charlotte, NC 28205

LOCATION Hwy 70 W. TR- on Hidden Brook (Bet Wind Forest)

SUBDIVISION Meadowcreek BLOCK / SECTION II LOT 19 LOT AREA .554 ac SITE CLASS. 5 DESIGN FLOW 360gpd L.T.A.R. .3

Septic Tank: 1000 Gallons; STB 799 Date 2-8-01
Pump Tank: Gallons; PT Date
Pump Make: Model Serial No.
Nitrification Field: No Fields 1 Square Feet 900 Linear Feet 300
No Lines 4 at 75' Trench Width 36" Max Trench Bottom Depth 18" Gravel Depth N/A

[X] New System [ ] Repair System Type: I, II, III, IV, V, VI
System Description: Gravity - 25% Reduction
Repair System Description: LPP
Maintenance Agreement Required: [ ] Yes [X] No

[X] House/Mod. Home No. Bedrooms 3
[ ] Mobile Home No. Bathrooms 2
[ ] Business No. Employees
[ ] Other


[ ] Slab [X] Crawl Space [ ] Basement w/plumbing [ ] Basement wo/plumbing

Water Supply: [ ] Individual [X] Public [ ] Community

Comments:/Conditions: Keep Septic System at least 10' from PL & House=5' & 25% Reduction in Drainfield Area

Comments:/Conditions: Date: Septic Installer -- 18" TB; may have to bring a 16" of cover for Drainfield or use System that requires only 6" cover, such as E-Z Lay or Cultec 100.

INITIAL SITE SKETCH Scale 1:50

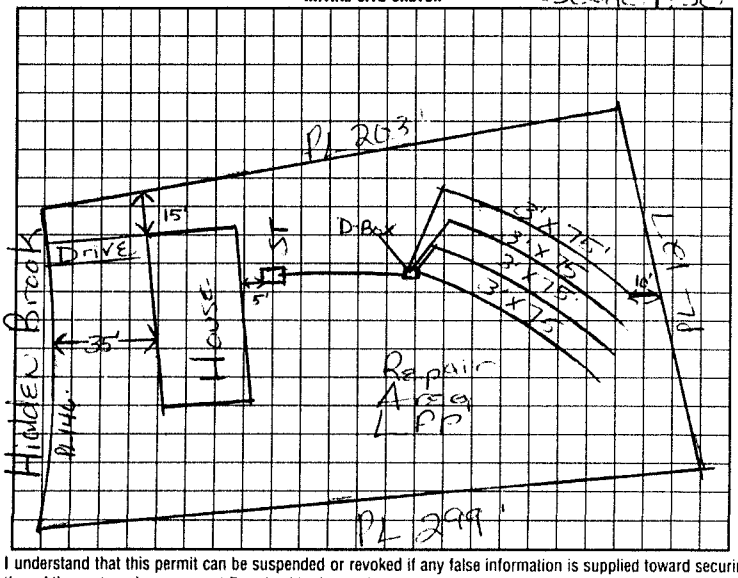

AS BUILT SKETCH

- Poly Flo Filter Installed
- Septic Tank marker Installed
- Installed 50 Infi/Quick Chambers Installed as Shown on Initial Site Sketch

I understand that this permit can be suspended or revoked if any false information is supplied toward securing the permit/any unauthorized changes are made to the site/any unauthorized changes are made in the installation of the system. Improvement Permit with plat valid without expiration. Improvement Permit with site plan valid for sixty months. Authorization to Construct is valid for a period equal to that of Improvement Permit – not to exceed sixty months.

Signed: Jeff Casey agent date 9/18/98 Installed by: Marty Tucker

Improvement Permit by: [illegible] date 8/26/98 Operation Permit by: William O. Johnson RS date 3/27/01

Authorization to Construct by: William O. Johnson RS date 3/13/01 Existing System Inspection by: date

HEALTH DEPT. COPY: WHITE INSPECTION COPY (FINAL): GREEN OWNER COPY (FINAL): YELLOW INSPECTION COPY (INITIAL): PINK OWNER COPY (INITIAL): GOLD