IREDELL COUNTY HEALTH DEPARTMENT

STATESVILLE 704-878-5305 CI MOORESVILLE 704-664-5281

IMPROVEMENT PERMIT / AUTHORIZATION TO CONSTRUCT / OPERATION PERMIT / EXISTING SYSTEM INSPECTION

PERMIT# 971389 PIN# 3792268055 (PT) DATE 9/14/98

OWNER OR CONTRACTOR Peeks Inc PHONE: Business 367-9536 Home

ADDRESS 5201 Monroe Rd Charlotte, NC 28205

LOCATION Hwy 16 W to Hidden Brook Dr. West on Oakstone Ct. RT

SUBDIVISION Meadowcreek BLOCK / SECTION II LOT 12 LOT AREA .55 Acre SITE CLASS PS DESIGN FLOW 360 gpd L.T.A.R. .3

Septic Tank: 1000 Gallons; STB 1012 Date 9-21-02
Pump Tank: ____ Gallons; PT ____ Date ____
Pump Make: ____ Model ____ Serial No. ____
Nitrification Field: No Fields 1 Square Feet 900' Linear Feet 300'
No Lines 3 at 100' Trench Width 36" Max Trench Bottom Depth 18-24" Gravel Depth N/A

[X] New System [ ] Repair System Type: I. II (III.) IV. V. VI
System Description: 25% Reduction - County
Repair System Description: Pump - Manifold
Maintenance Agreement Required: [ ] Yes [X] No

[ ] House/Mod. Home No. Bedrooms 3
[X] Mobile Home No. Bathrooms 2
[ ] Business No. Employees ____
[ ] Other ____


[ ] Slab [X] Crawl Space [ ] Basement w/plumbing [ ] Basement wo/plumbing

Water Supply: [ ] Individual [X] Public [ ] Community


Comments:/Conditions: Keep Septic System out of Low area, Divert Surface/Storm Water Away from Drain Field. Installer note 18" TB; may bring in 6" of cover or use System that only requires 6" of cover.

Comments:/Conditions: (Replacement - Debris Area must be Cleaned-up & Removed prior to using for Drainfield) S.T. Marker Installed - Tank-Tite Filter Installed; Installed 30 yds of Type 57 Stone

INITIAL SITE SKETCH Scale 1:50

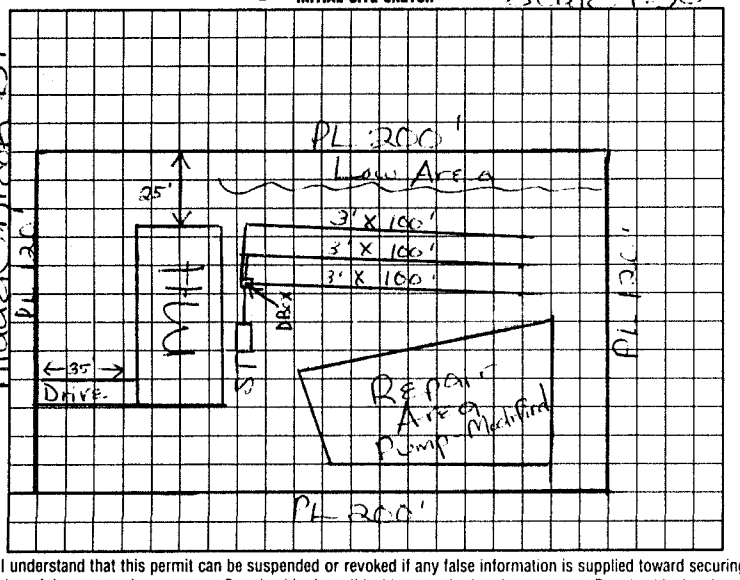

AS BUILT SKETCH Section of Eg-Lay

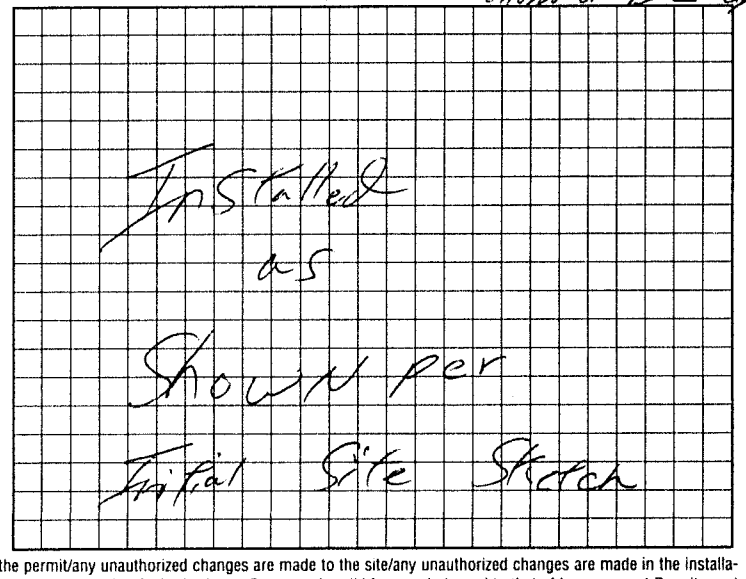

I understand that this permit can be suspended or revoked if any false information is supplied toward securing the permit/any unauthorized changes are made to the site/any unauthorized changes are made in the installation of the system. Improvement Permit with plat valid without expiration. Improvement Permit with site plan valid for sixty months. Authorization to Construct is valid for a period equal to that of Improvement Permit – not to exceed sixty months.

Signed: Jeff Casey agent date 9/18/98 Installed by: A-1 Backhoe

Improvement Permit by: [signature] date 9/14/98 Operation Permit by: William G. Johnson date 9/18/02

Authorization to Construct by: [signature] date 08/2/02 Existing System Inspection by: ____ date ____

HEALTH DEPT. COPY: WHITE INSPECTION COPY (FINAL): GREEN OWNER COPY (FINAL): YELLOW INSPECTION COPY (INITIAL): PINK OWNER COPY (INITIAL): GOLD