IREDELL COUNTY HEALTH DEPARTMENT

STATESVILLE 704-878-5305 MOORESVILLE 704-664-5281

IMPROVEMENT PERMIT / AUTHORIZATION TO CONSTRUCT / OPERATION PERMIT / EXISTING SYSTEM INSPECTION

PERMIT# 120532 PIN# 4703-11-2024 DATE 5-12-04

OWNER OR CONTRACTOR Luv Homes of Troutman (Courtney Tate) PHONE: Business (704) 528-0848 Home

ADDRESS 1036 Charlotte Hwy Troutman NC 28166

LOCATION US 70W TL Hiddenbrook Lot #19 toward end on right

SUBDIVISION Meadow Creek BLOCK / SECTION LOT 19 LOT AREA .79 SITE CLASS. PS DESIGN FLOW 360 L.T.A.R. .3 gpd/ft2

Septic Tank: 1000 Gallons; STB 1012 Date 11-14-03
Pump Tank: Gallons; PT Date
Pump Make: Model Serial No.
Nitrification Field: No Fields 1 Square Feet Linear Feet 300
No Lines 5 Trench Width 36" Max Trench Bottom Depth 20" Gravel Depth N/A

☑ New System ☐ Repair System Type: I, II, III, IV, V, VI
System Description: Gravity 25% reduction
Repair System Description: LP Panel 50% Red
Maintenance Agreement Required: ☐ Yes ☑ No


☐ House/Mod. Home No. Bedrooms 3
☑ Mobile Home No. Bathrooms 2
☐ Business No. Employees
☐ Other
☐ Slab ☐ Crawl Space ☐ Basement w/plumbing ☐ Basement wo/plumbing

Water Supply: ☐ Individual ☑ Public ☐ Community


Comments/Conditions: ① Install lines 20" on contour ② Maintain setbacks ③ Pack and fill gullies beside house

Comments/Conditions: Tuff Tite filter + ST marker Installed - 48 Infiltrator Chambers Installed

Scale 1"=50' INITIAL SITE SKETCH

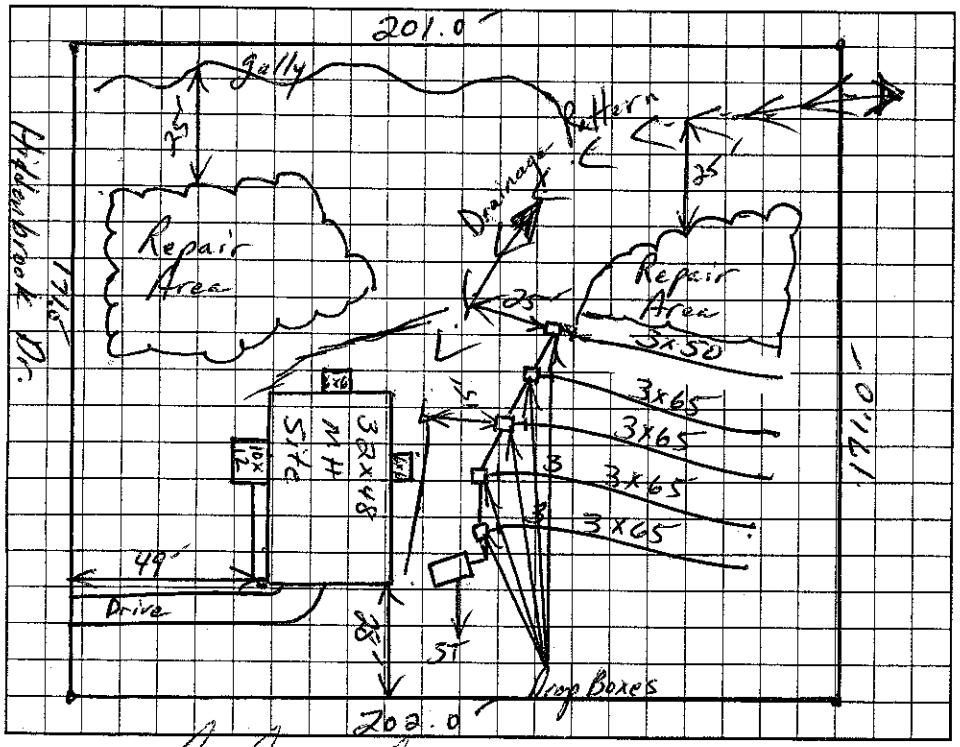

AS BUILT SKETCH

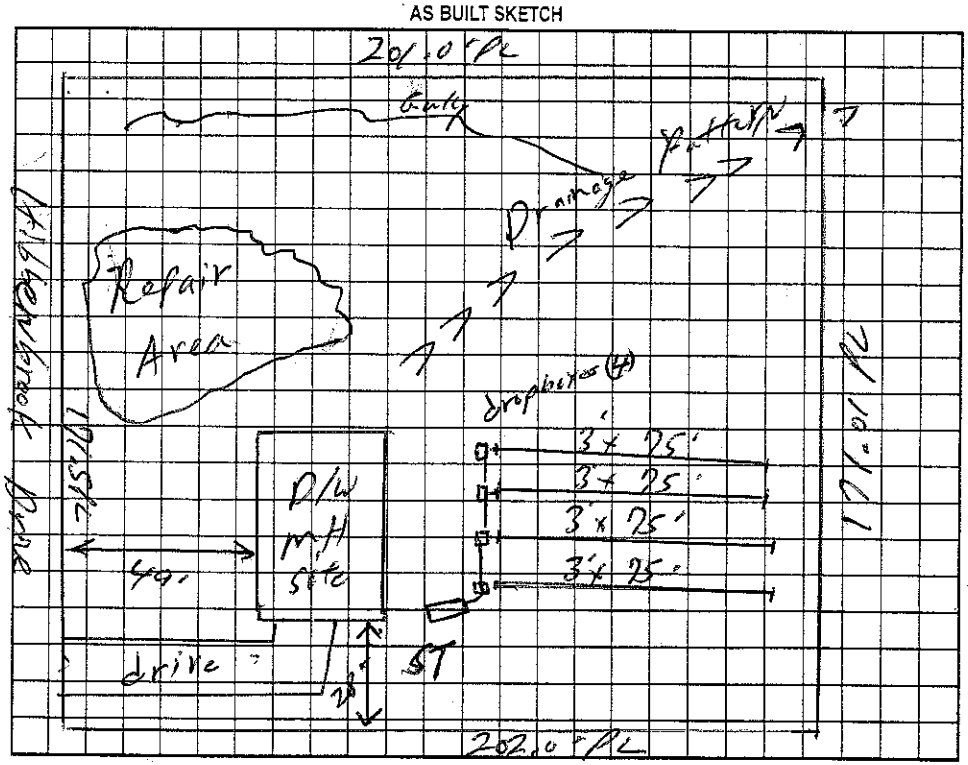

Permit can be suspended or revoked if any false information is supplied toward securing the permit/any unauthorized changes are made to the site/any unauthorized changes are made in the installation of the system. Improvement Permit with plat valid without expiration. Improvement Permit with site plan valid for sixty months. Authorization to Construct is valid for a period equal to that of Improvement Permit – not to exceed sixty months.

Signed: date 5/14/04 Installed by: A+ Backhoe

Improvement Permit by: Christopher M. Shuler PE date 5-12-04 Operation Permit by: William O. John date 5/21/04

Authorization to Construct by: Christopher M. Shuler PE date 5-12-04 Existing System Inspection by: date

HEALTH DEPT. COPY: WHITE OWNER COPY (FINAL): YELLOW OWNER COPY (INITIAL): PINK