IREDELL COUNTY HEALTH DEPARTMENT

STATESVILLE 704-878-5305 MOORESVILLE 704-664-5281

IMPROVEMENT PERMIT / AUTHORIZATION TO CONSTRUCT / OPERATION PERMIT / EXISTING SYSTEM INSPECTION

PERMIT# 07149H PIN# 3792268055 (PT) DATE 7/20/98

OWNER OR CONTRACTOR Reeks Inc. PHONE: Business (704) 561-9536 Home

ADDRESS 5201 Monroe Rd Charlotte, NC

LOCATION Hwy 70 W TR Hidden Brook past Oak Stone Ln left

SUBDIVISION Meadowbrook BLOCK / SECTION II LOT 30 LOT AREA 1.62 Acre SITE CLASS PS DESIGN FLOW 360 gpd L.T.A.R. .3

Septic Tank: 1000 Gallons; STB Date

Pump Tank: Gallons; PT Date

Pump Make: Model Serial No.

Nitrification Field: No Fields 1 Square Feet 1200' Linear Feet 400'

No Lines 6 at 67' Trench Width 36" Max Trench Bottom Depth 35-36" Gravel Depth 12"

[X] New System [ ] Repair System Type: I (II) III IV V VI

System Description: Gravity Conventional

Repair System Description: Pump/Grav Mod Sand

Maintenance Agreement Required: [ ] Yes [X] No

[ ] House/Mod. Home No. Bedrooms 3

[X] Mobile Home No. Bathrooms 2

[ ] Business No. Employees

[ ] Other


[ ] Slab [X] Crawl Space [ ] Basement w/plumbing [ ] Basement wo/plumbing

Water Supply: [ ] Individual [X] Public [ ] Community


Comments:/Conditions: Keep Septic System at least 10' From PL & 5' From House

Comments:/Conditions:

INITIAL SITE SKETCH 210' Scale 1:50

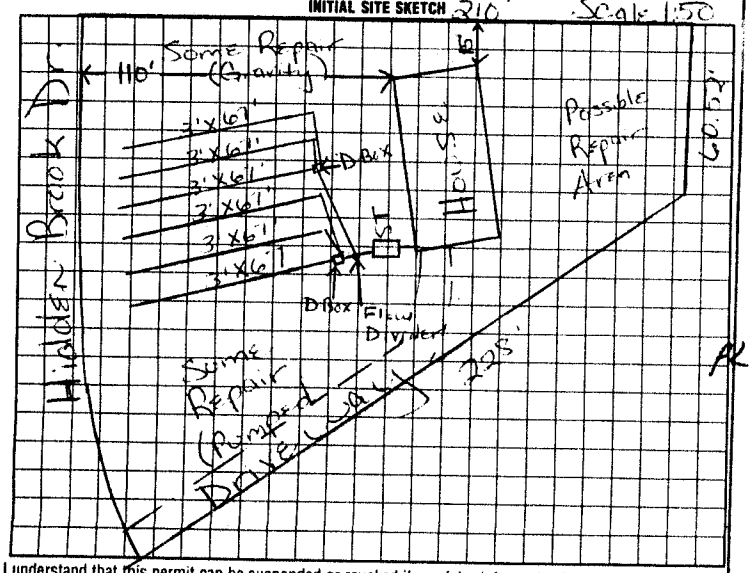

AS BUILT SKETCH

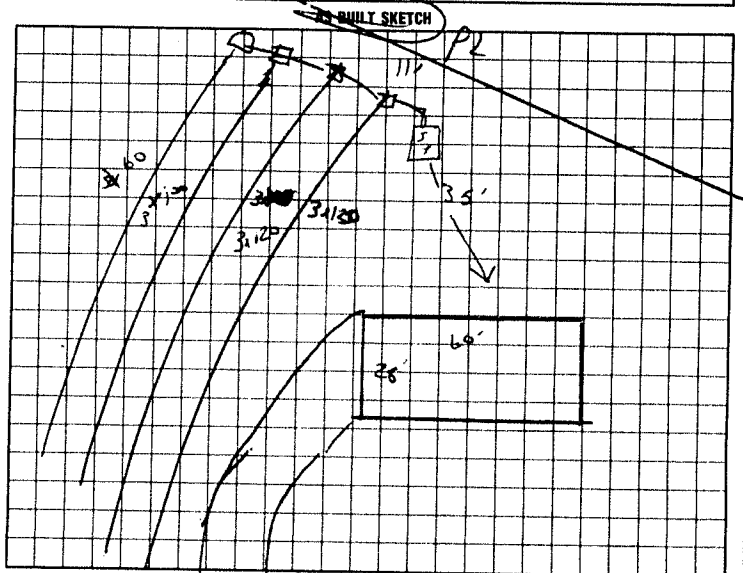

I understand that this permit can be suspended or revoked if any false information is supplied toward securing the permit/any unauthorized changes are made to the site/any unauthorized changes are made in the installation of the system. Improvement Permit with plat valid without expiration. Improvement Permit with site plan valid for sixty months. Authorization to Construct is valid for a period equal to that of Improvement Permit – not to exceed sixty months.

Signed: Jeff Cadney agent date 9/18/98

Improvement Permit by: [illegible] date 7/20/98

Authorization to Construct by: [illegible] date 7.28.98

Installed by: C & W Grading Hidden Brook

Operation Permit by: [illegible] date 7.30.99

Existing System Inspection by: date

HEALTH DEPT. COPY: WHITE INSPECTION COPY (FINAL): GREEN OWNER COPY (FINAL) YELLOW INSPECTION COPY (INITIAL) PINK OWNER COPY (INITIAL) GOLD