IREDELL COUNTY HEALTH DEPARTMENT

STATESVILLE 704-878-5305 MOORESVILLE 704-664-5281

IMPROVEMENT PERMIT / AUTHORIZATION TO CONSTRUCT / OPERATION PERMIT / EXISTING SYSTEM INSPECTION

PERMIT# 71496 PIN# 3792 26 8055 P.T. DATE 1-7-99

OWNER OR CONTRACTOR Peeks Inc. PHONE: Business 567-9836 Home

ADDRESS 5201 monroe Rd Charlotte N.C. 28205

LOCATION Hwy 70 west TL Hidden Brook Just Past oak ~~tree~~ stone

SUBDIVISION meadow creek BLOCK / SECTION II LOT 32 LOT AREA 1.65 acres SITE CLASS PS DESIGN FLOW 360 L.T.A.R. .3

Septic Tank: 1000 Gallons; STB 1012 Date 9-20-98

Pump Tank: 1000 Gallons; PT 17 Date 9-20-98

Pump Make: ~~Hydromatic~~ Model SK60A.I Serial No.

Nitrification Field: No Fields 1 Square Feet 900 Linear Feet 300

No Lines 5 Trench Width 36" Max Trench Bottom Depth 24" Gravel Depth N/A

☑ New System ☐ Repair System Type: I, II, III, IV, V, VI

System Description: Pump To Easy Lay

Repair System Description: LPP Shallow Depth

Maintenance Agreement Required: ☐ Yes ☑ No

☐ House/Mod. Home No. Bedrooms 3

☐ Mobile Home No. Bathrooms 2

☐ Business No. Employees

☐ Other


☐ Slab ☐ Crawl Space ☐ Basement w/plumbing ☐ Basement wo/plumbing

Water Supply: ☐ Individual ☑ Public ☐ Community


Comments/Conditions: See Attach Sheets for P.T. & Pressure manifold set up which become part of this Permit.

Comments/Conditions: Replaces Permit issued 9-3-98 TANKS & DRAINFIELDS INSPECTED 2-9-99 CMH.

INITIAL SITE SKETCH 201'

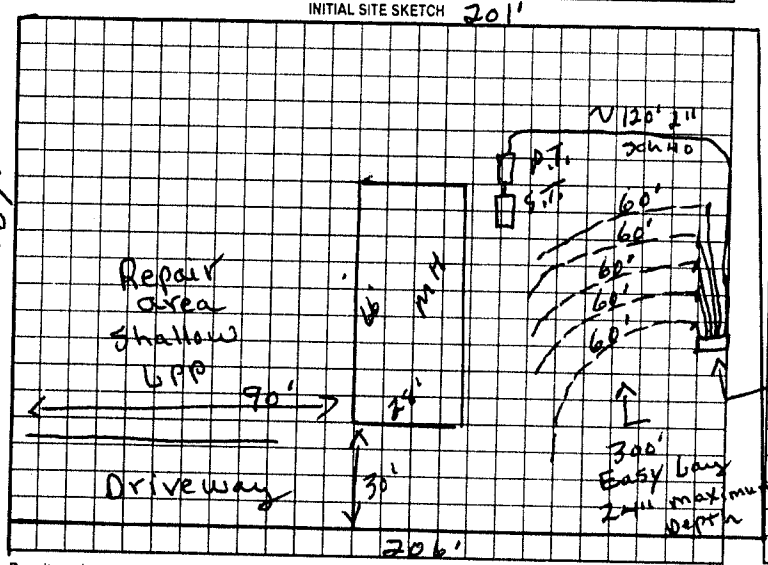

AS BUILT SKETCH

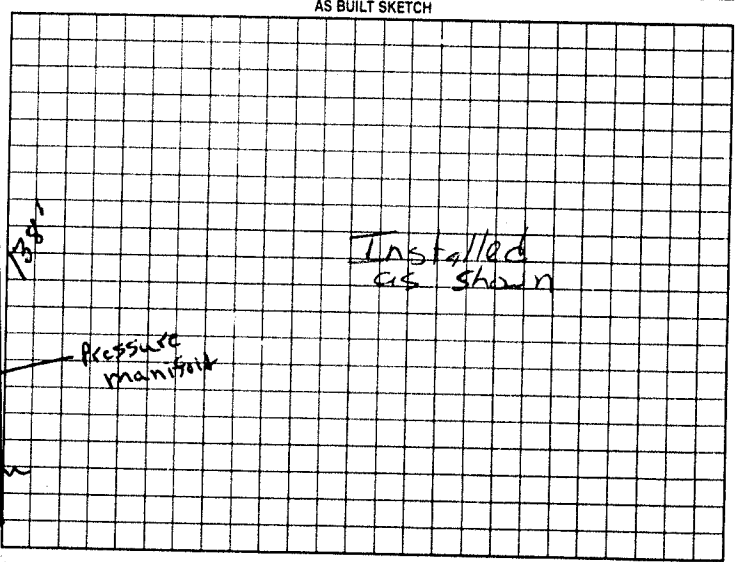

139'

Permit can be suspended or revoked if any false information is supplied toward securing the permit/any unauthorized changes are made to the site/any unauthorized changes are made in the installation of the system. Improvement Permit with plat valid without expiration. Improvement Permit with site plan valid for sixty months. Authorization to Construct is valid for a period equal to that of Improvement Permit – not to exceed sixty months.

Signed: [signature] date 1-11-99 Installed by: A-1 Backhoe

Improvement Permit by: P. C. Moore date 1-7-99 Operation Permit by: [signature] date 8-17-99

Authorization to Construct by: P. C. Moore date 1-7-99 Existing System Inspection by: date

HEALTH DEPT. COPY: WHITE OWNER COPY (FINAL): YELLOW OWNER COPY (INITIAL): PINK