IREDELL COUNTY HEALTH DEPARTMENT

STATESVILLE 704-878-5305 MOORESVILLE 704-664-5281

IMPROVEMENT PERMIT / AUTHORIZATION TO CONSTRUCT / OPERATION PERMIT / EXISTING SYSTEM INSPECTION

PERMIT# 071488 PIN# 3792268055 (PT) DATE 7/19/98

OWNER OR CONTRACTOR Peeks Inc PHONE: Business (704) 561-9836 Home

ADDRESS 5201 Monroe Rd. Charlotte NC 28205

LOCATION Hwy 70 W TL Hidden Brook Dr GB4 (Wire Fence) Near end on left

SUBDIVISION Meadow Creek BLOCK / SECTION II LOT 26 LOT AREA .794 acre SITE CLASS PS DESIGN FLOW 360gpd L.T.A.R. .3

Septic Tank: 1000 Gallons; STB 1012 Date 6-11-00

Pump Tank: ____ Gallons; PT ____ Date ____

Pump Make: ____ Model ____ Serial No. ____

Nitrification Field: No Fields 1 Square Feet 1400' Linear Feet 400'

No Lines 5 at 80' Trench Width 36" Max Trench Bottom Depth 28" Gravel Depth 12"

[X] New System [ ] Repair System Type: I (II) III, IV, V, VI

System Description: Gravity - Conventional

Repair System Description: Grav/Pump - Modified

Maintenance Agreement Required: [ ] Yes [X] No

[ ] House/Mod. Home [X] Mobile Home [ ] Business [ ] Other

No. Bedrooms 3 No. Bathrooms 2 No. Employees ____


[ ] Slab [X] Crawl Space [ ] Basement w/plumbing [ ] Basement wo/plumbing

Water Supply: [ ] Individual [X] Public [ ] Community

Comments:/Conditions: Keep Septic System At least 10' From PL & 5' From House Note: Ditch From Silt Pond Needs to be Taken down PL to Gulley

Comments:/Conditions: SEPTIC TANK W/ RISERS AND MARKER INSTALLED USING "POLYLOK" FILTER

INITIAL SITE SKETCH Scale 1:50

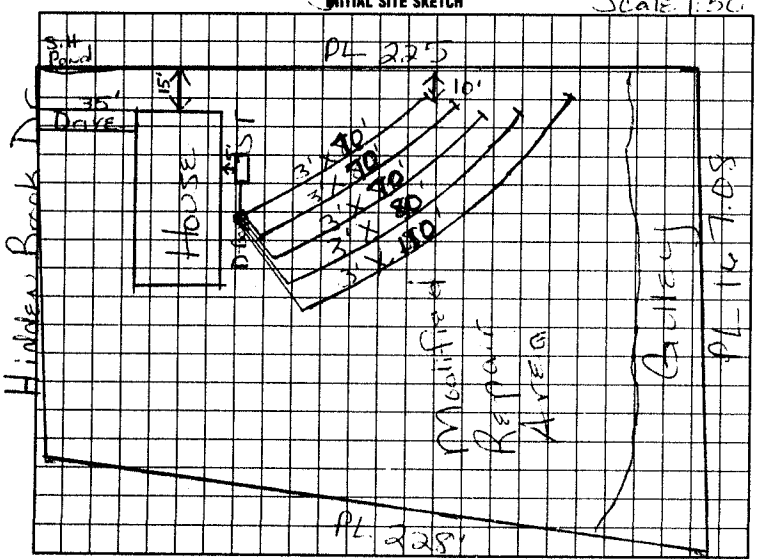

AS BUILT SKETCH

SYSTEM INSTALLED ACCORDING TO INITAL SITE SKETCH

I understand that this permit can be suspended or revoked if any false information is supplied toward securing the permit/any unauthorized changes are made to the site/any unauthorized changes are made in the installation of the system. Improvement Permit with plat valid without expiration. Improvement Permit with site plan valid for sixty months. Authorization to Construct is valid for a period equal to that of Improvement Permit – not to exceed sixty months.

Signed: Jeff Casey agent date 9/18/98

Improvement Permit by: Mona Hall Watson date 8/19/98

Authorization to Construct by: STEVE HEDRICK date 8-18-00

Installed by: A. I Backhoe

Operation Permit by: STEVE HEDRICK date 8-18-00

Existing System Inspection by: ____ date ____

HEALTH DEPT. COPY: WHITE INSPECTION COPY (FINAL): GREEN OWNER COPY (FINAL): YELLOW INSPECTION COPY (INITIAL): PINK OWNER COPY (INITIAL): GOLD