IREDELL COUNTY HEALTH DEPARTMENT

STATESVILLE 704-878-5305 MOORESVILLE 704-664-5281

IMPROVEMENT PERMIT / AUTHORIZATION TO CONSTRUCT / OPERATION PERMIT / EXISTING SYSTEM INSPECTION

PERMIT# 071499 PIN# 3792268055 (PT) DATE 8/31/98

OWNER OR CONTRACTOR Peeks Inc PHONE: Business (704) 541-9836 Home

ADDRESS 5701 Monroe Rd Charlotte N.C. 28205

LOCATION Hwy 70 W TL Hidden Brook TL on Oakstone on Right

SUBDIVISION Meadowcreek BLOCK / SECTION II LOT 35 LOT AREA .53 Acre SITE CLASS. A5 DESIGN FLOW 360 gpd L.T.A.R. .3

Septic Tank: 1000 Gallons; STB ____ Date ____

Pump Tank: ____ Gallons; PT ____ Date ____

Pump Make: ____ Model ____ Serial No. ____

Nitrification Field: No Fields ____ Square Feet 900* Linear Feet 300*

No Lines 4 at 75' Trench Width 36" Max Trench Bottom Depth ____ Gravel Depth N/A

[X] New System [ ] Repair System Type: I, II, (III), IV, V, VI

System Description: Gravity - 25% Reduction

Repair System Description: Proposal - Modified

Maintenance Agreement Required: [ ] Yes [X] No

[ ] House/Mod. Home No. Bedrooms 3

[X] Mobile Home No. Bathrooms 2

[ ] Business No. Employees ____

[ ] Other ____


[ ] Slab [X] Crawl Space [ ] Basement w/plumbing [ ] Basement wo/plumbing

Water Supply: [ ] Individual [X] Public [ ] Community


Comments:/Conditions: *25% Reduction IN Drainfield Area. Keep Septic System at least 10' from PL & 57' from House

Comments:/Conditions:

INITIAL SITE SKETCH Scale 1:50

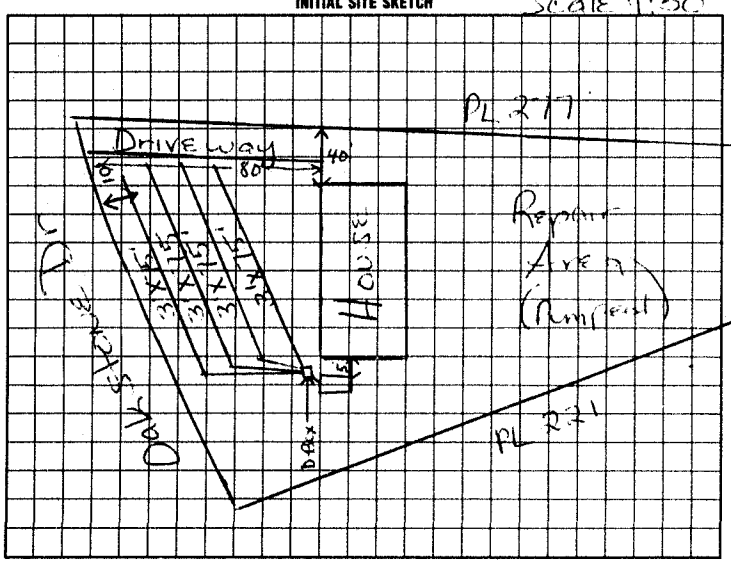

AS BUILT SKETCH

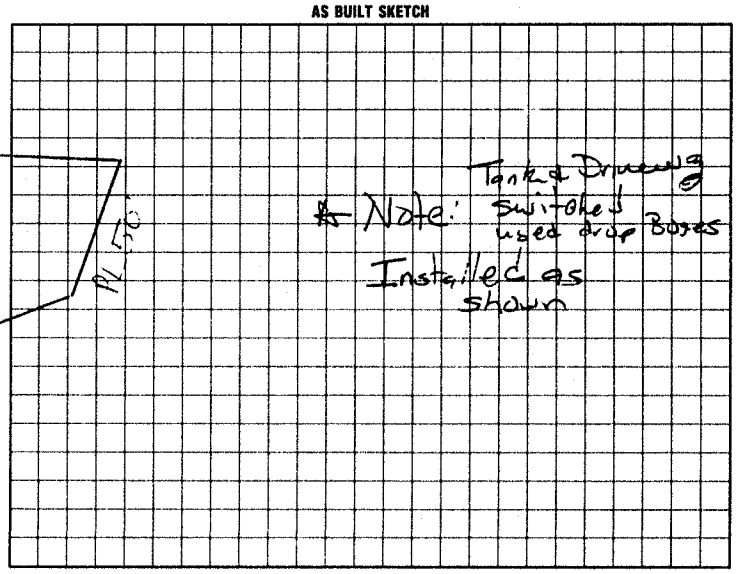

I understand that this permit can be suspended or revoked if any false information is supplied toward securing the permit/any unauthorized changes are made to the site/any unauthorized changes are made in the installation of the system. Improvement Permit with plat valid without expiration. Improvement Permit with site plan valid for sixty months. Authorization to Construct is valid for a period equal to that of Improvement Permit – not to exceed sixty months.

Signed: Jeff Casey agent date 9/18/98

Improvement Permit by: Virginia A. Patterson date 5/31/99

Authorization to Construct by: Mark Cox IRS date 7-29-99

Installed by: A-1 Backhoe

Operation Permit by: Mark Cox IRS date 7-29-99

Existing System Inspection by: ____ date ____

HEALTH DEPT. COPY: WHITE INSPECTION COPY (FINAL): GREEN OWNER COPY (FINAL): YELLOW INSPECTION COPY (INITIAL): PINK OWNER COPY (INITIAL): GOLD