IREDELL COUNTY HEALTH DEPARTMENT

STATESVILLE 704-878-5305 MOORESVILLE 704-664-5281

IMPROVEMENT PERMIT / AUTHORIZATION TO CONSTRUCT / OPERATION PERMIT / EXISTING SYSTEM INSPECTION

PERMIT# 071504 PIN# 3792268055 (PT) DATE 8-17-98

OWNER OR CONTRACTOR Peeks Inc PHONE: Business (704) 567-9853 Home

ADDRESS 5201 Monroe Rd Charlotte, N.C.

LOCATION Hwy 70W TL #4 Windsor Forest on Hidden Brook TL Oakstone

SUBDIVISION Meadowcreek BLOCK / SECTION II LOT 39 LOT AREA 1.645 Acre SITE CLASS. PS DESIGN FLOW 360gpd L.T.A.R. .3

Septic Tank: 1000 Gallons; STB 3/2 Dallings Date 8/99

Pump Tank: Gallons; PT Date

Pump Make: Model Serial No.

Nitrification Field: No Fields 1 Square Feet 1200' Linear Feet 400'

No Lines 4at 100' Trench Width 36" Max Trench Bottom Depth 36" Gravel Depth 12"

☒ New System ☐ Repair System Type: I, II, III, IV, V, VI

System Description: Gravity - Conventional

Repair System Description: Same

Maintenance Agreement Required: ☐ Yes ☒ No

☐ House/Mod. Home ☒ Mobile Home ☐ Business ☐ Other

No. Bedrooms 3 No. Bathrooms 2 No. Employees


☐ Slab ☒ Crawl Space ☐ Basement w/plumbing ☐ Basement wo/plumbing

Water Supply: ☐ Individual ☒ Public ☐ Community


Comments:/Conditions: Keep Septic System 5' From House & 10' From PL.

Comments:/Conditions: 3-16 Last Two Lines Installed As Shown. 3-24-2000 Top Two Lines Installed Top Line 110 Ft 2nd 90 Ft 1st & 2nd Line Covered w/ Butcher Paper And Some Siltring due To Rain

INITIAL SITE SKETCH Scale 1:50

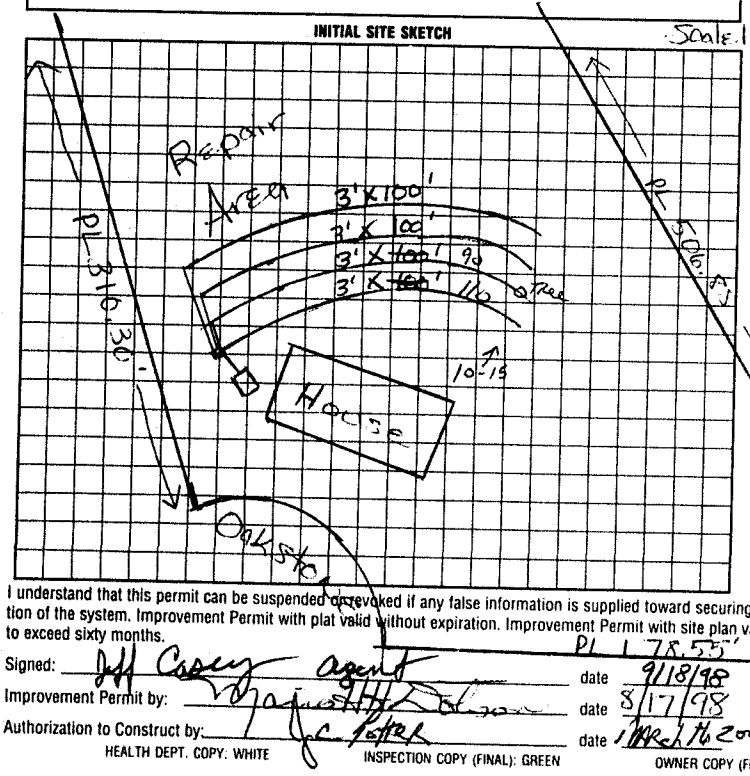

AS BUILT SKETCH

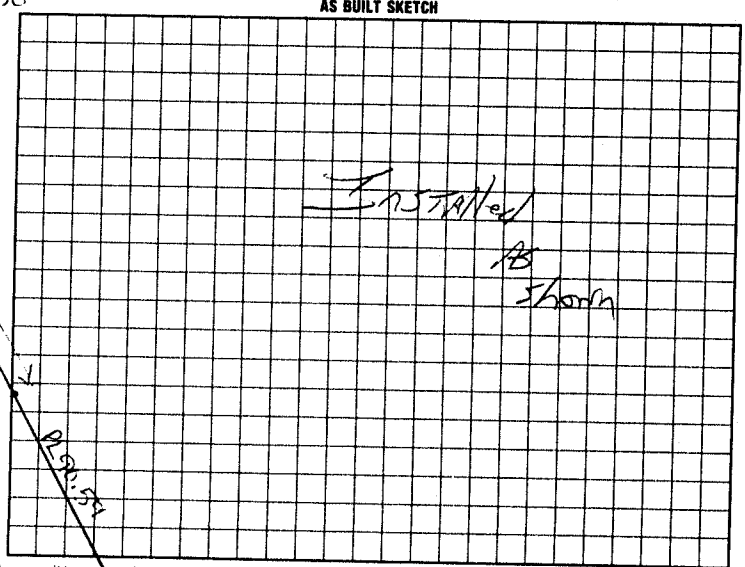

I understand that this permit can be suspended or revoked if any false information is supplied toward securing the permit/any unauthorized changes are made to the site/any unauthorized changes are made in the installation of the system. Improvement Permit with plat valid without expiration. Improvement Permit with site plan valid for sixty months. Authorization to Construct is valid for a period equal to that of Improvement Permit – not to exceed sixty months.

Signed: Jeff Casey agent date 9/18/98

Improvement Permit by: [signature] date 8/17/98

Authorization to Construct by: [signature] date 3/16/2000

Installed by: Reid Ecky

Operation Permit by: [signature] date March 24, 2000

Existing System Inspection by: date

HEALTH DEPT. COPY: WHITE INSPECTION COPY (FINAL): GREEN OWNER COPY (FINAL): YELLOW INSPECTION COPY (INITIAL): PINK OWNER COPY (INITIAL): GOLD