Paid 125.00

THIS PERMIT VOIDS PREVIOUS ISSUED 8-29-98

IREDELL COUNTY HEALTH DEPARTMENT

STATESVILLE 704-878-5305 MOORESVILLE 704-664-5281

IMPROVEMENT PERMIT / AUTHORIZATION TO CONSTRUCT / OPERATION PERMIT / EXISTING SYSTEM INSPECTION

PERMIT# 071510 PIN# DATE 2-1-01

OWNER OR CONTRACTOR JOYCE & ROBERT EARLEY PHONE: Business Home 878-6057

ADDRESS 107 POST LANE, STATESVILLE, NC 28625

LOCATION US 70 WEST, TL HIDDEN BROOK DR TL, OAKSTONE DR, 4TH LOT ON LEFT

SUBDIVISION MEADOW CREEK BLOCK / SECTION II LOT 45 LOT AREA 1.51 ACRES SITE CLASS P3 DESIGN FLOW 360 L.T.A.R. 0.30 GPD/FT²

Septic Tank: 1000 Gallons; STB 794 Date 2-6-01

Pump Tank: Gallons; PT Date

Pump Make: Model Serial No

Nitrification Field: No Fields 1 Square Feet EQ. TO 1200 Linear Feet 300+

No Lines 5 IX Trench Width 36" Max Trench Bottom Depth 36" Gravel Depth N/A

☑ New System ☐ Repair System Type: I II (III) IV V

System Description: 25% REDUCTION, GRAVITY

Repair System Description: CONVENTIONAL, PUMP

Maintenance Agreement Required: ☐ Yes ☑ No

☐ House/Mod. Home ☒ Mobile Home ☐ Business ☐ Other

No. Bedrooms 3 No. Bathrooms 2 No. Employees


☐ Slab ☑ Crawl Space ☐ Basement w/plumbing ☐ Basement wo/plumbing

Water Supply: ☐ Individual ☒ Public ☐ Community


Comments/Conditions: INSTALL 25% REDUCTION SYSTEM USING FIFTY (50) CHAMBERS OR THIRTY (30) HDS SECTIONS ON CONTOUR AS FLAGGED

Comments/Conditions: ① SEPTIC TANK WITH MARKER INSTALLED USING "POLYLOK" FILTER. ② SYSTEM INSTALLED ACCORDING TO INITIAL SITE SKETCH USING 30 HDS SECTIONS

INITIAL SITE SKETCH

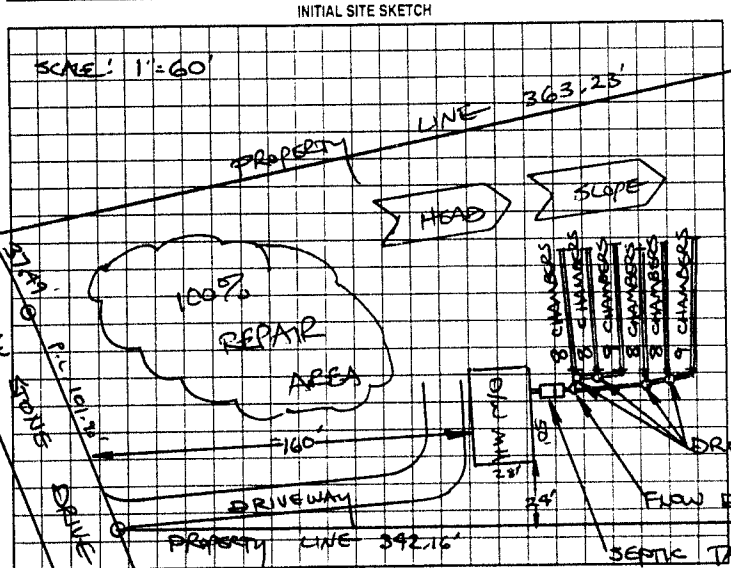

AS BUILT SKETCH

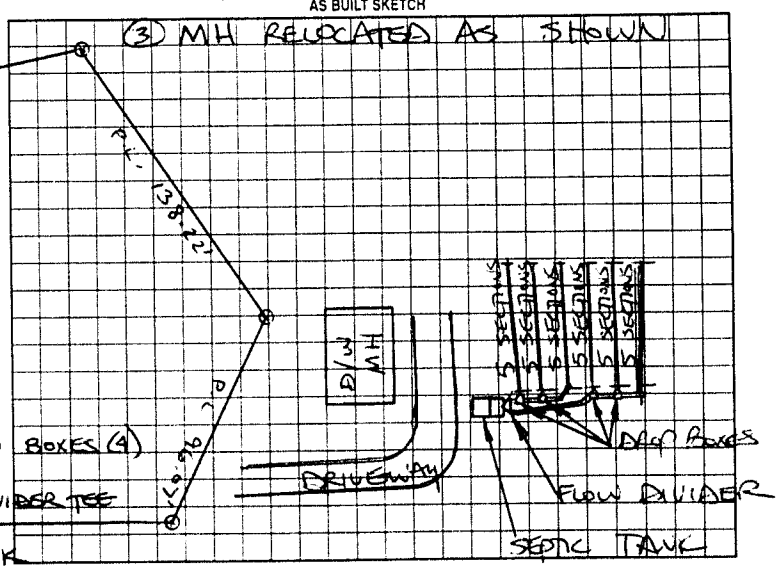

Permit can be suspended or revoked if any false information is supplied toward securing the permit; any unauthorized changes are made to the site; any unauthorized changes are made in the installation of the system. Improvement Permit with plat valid without expiration. Improvement Permit with site plan valid for sixty months. Authorization to Construct is valid for a period equal to that of Improvement Permit – not to exceed sixty months.

Signed: Joyce Cook date 2-2-01 Installed by ANDY DANIELS

Improvement Permit by: STEVE HEDRICK date 2-1-01 Operation Permit by: STEVE HEDRICK date 3-28-01

Authorization to Construct by: STEVE HEDRICK date 2-1-01 Existing System Inspection by: date

HEALTH DEPT. COPY WHITE OWNER COPY (FINAL) YELLOW OWNER COPY (INITIAL) PINK