IREDELL COUNTY HEALTH DEPARTMENT

STATESVILLE 704-878-5305 MOORESVILLE 704-664-5281 (C1)

IMPROVEMENT PERMIT / AUTHORIZATION TO CONSTRUCT / OPERATION PERMIT / EXISTING SYSTEM INSPECTION

PERMIT# 111586 PIN# 4703-11-8647 DATE 3-7-03

OWNER OR CONTRACTOR DRI ENTERPRISES PHONE: Business 704-483-1035 ~~Home~~ FAX 704-483-6673

ADDRESS 6255 Hwy 150 EAST DENVER NC 28037

LOCATION US 70 WEST TL HIDDEN BROOK DR TL OAK STONE DR, 6TH LOT ON LEFT

SUBDIVISION MEADOW CREEK BLOCK / SECTION ____ LOT 43 LOT AREA 0.740 ACRE SITE CLASS. PS1 DESIGN FLOW 360 L.T.A.R. 0.30 GPD/FT²

Septic Tank: 1000 Gallons; STB 1012 Date 4-10-99

Pump Tank: ____ Gallons; PT ____ Date ____

Pump Make: ____ Model ____ Serial No. ____

Nitrification Field: No Fields 1 Square Feet 1200 Linear Feet 400'

No Lines FOUR Trench Width 36" Max Trench Bottom Depth ____ Gravel Depth 12"

☐ New System ☐ Repair System Type: I (II) III. IV. V. VI

System Description: CONVENTIONAL, GRAVITY

Repair System Description: ____

Maintenance Agreement Required: ☐ Yes ☑ No

☐ House/Mod. Home No. Bedrooms 3

☑ Mobile Home No. Bathrooms 2

☐ Business No. Employees ____

☐ Other ____


☐ Slab ☑ Crawl Space ☐ Basement w/plumbing ☐ Basement wo/plumbing

Water Supply: ☐ Individual ☑ Public ☐ Community


Comments:/Conditions:

Comments:/Conditions: KEEP MH FOUNDATION MINIMUM FIVE (5) FEET FROM SYSTEM

INITIAL SITE SKETCH

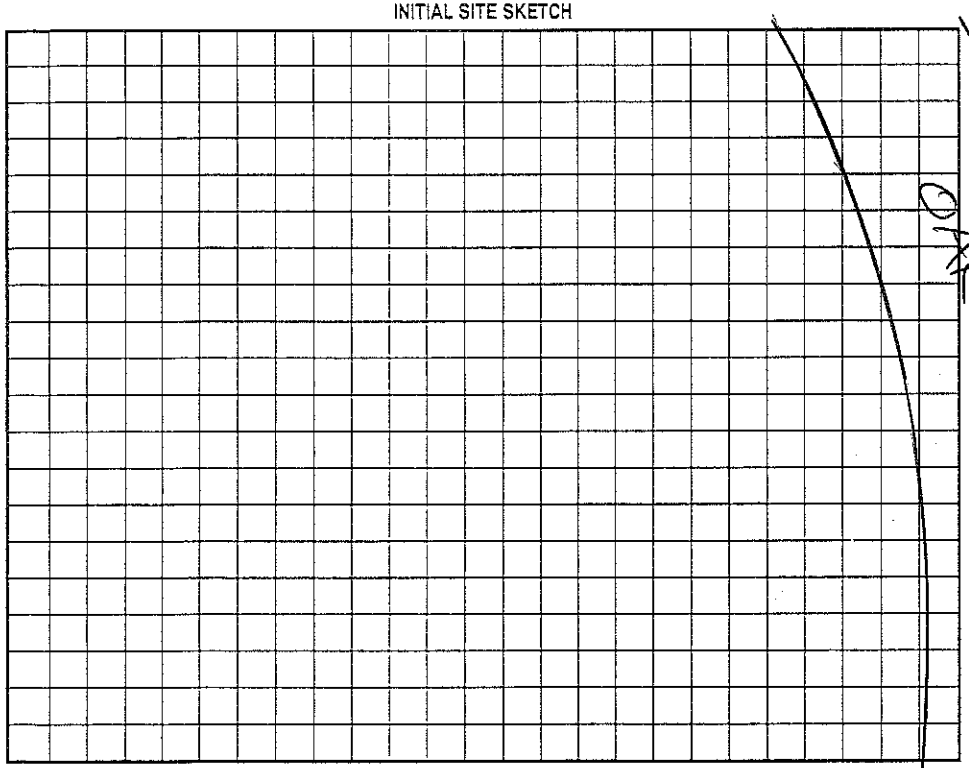

AS BUILT SKETCH

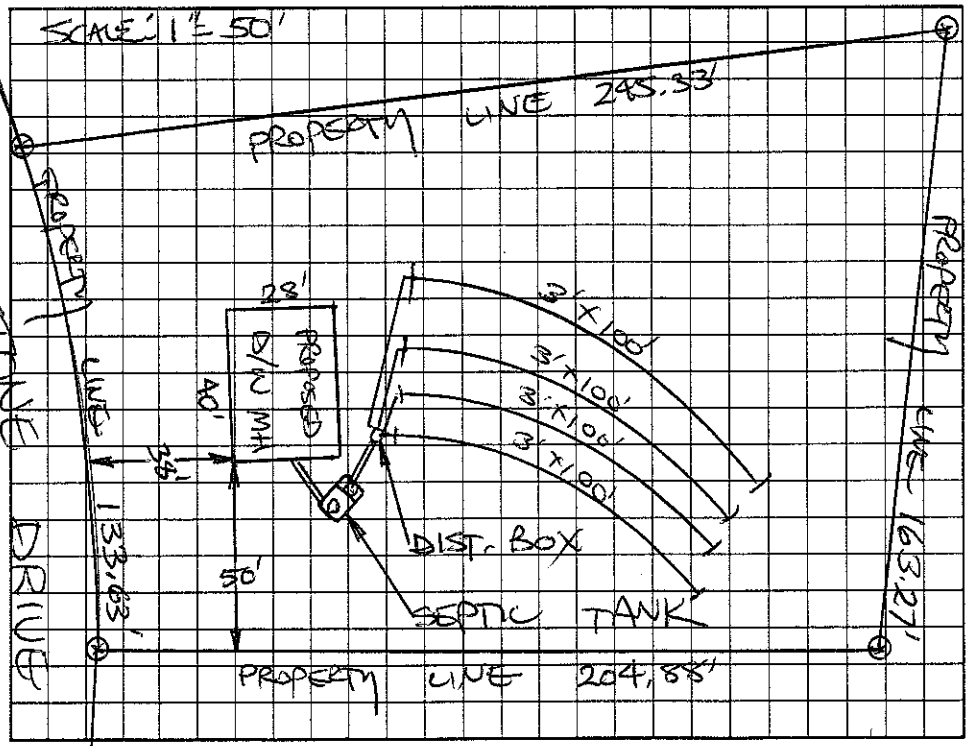

Permit can be suspended or revoked if any false information is supplied toward securing the permit/any unauthorized changes are made to the site/any unauthorized changes are made in the installation of the system. Improvement Permit with plat valid without expiration. Improvement Permit with site plan valid for sixty months. Authorization to Construct is valid for a period equal to that of Improvement Permit – not to exceed sixty months.

Signed: ____ date ____ Installed by: ____

Improvement Permit by: ____ date ____ Operation Permit by: ____ date ____

Authorization to Construct by: ____ date ____ Existing System Inspection by: STEVE HEDRICK date 3-7-03

HEALTH DEPT. COPY: WHITE OWNER COPY (FINAL): YELLOW OWNER COPY (INITIAL): PINK