IREDELL COUNTY HEALTH DEPARTMENT

STATESVILLE 704-878-5305 MOORESVILLE 704-664-5281

IMPROVEMENT PERMIT / AUTHORIZATION TO CONSTRUCT / OPERATION PERMIT / EXISTING SYSTEM INSPECTION

PERMIT# 071508 PIN# 3792 26 8055 (PT) DATE 8/25/98

OWNER OR CONTRACTOR Peeks Enc PHONE: Business Home

ADDRESS 5201 Monroe Rd Charlotte, NC

LOCATION Hwy 70 W TL Hidden Brook TL Oakstone Dr - Near end on left

SUBDIVISION Meadowview BLOCK / SECTION II LOT 43 LOT AREA .74 Acre SITE CLASS. FS DESIGN FLOW 360gpd L.T.A.R. .3

Septic Tank: 1000 Gallons; STB 1012 Date 4-10-99
Pump Tank: Gallons; PT Date
Pump Make: Model Serial No.
Nitrification Field: No Fields 1 Square Feet 1200' Linear Feet 1400'
No Lines 4@100' Trench Width 36" Max Trench Bottom Depth 18" Gravel Depth 12"

☒ New System ☐ Repair System Type: I, II, III, IV, V, VI
System Description: Gravity-Conventional
Repair System Description: Gravity-Modified
Maintenance Agreement Required: ☐ Yes ☒ No

☐ House/Mod. Home No. Bedrooms 3
☒ Mobile Home No. Bathrooms 2
☐ Business No. Employees
☐ Other
☐ Slab ☒ Crawl Space ☐ Basement w/plumbing ☐ Basement wo/plumbing


Water Supply: ☐ Individual ☒ Public ☐ Community

Comments:/Conditions: Keep Septic System at least 5' From House & 10' From PL


Comments:/Conditions:

Scale 1:50

INITIAL SITE SKETCH

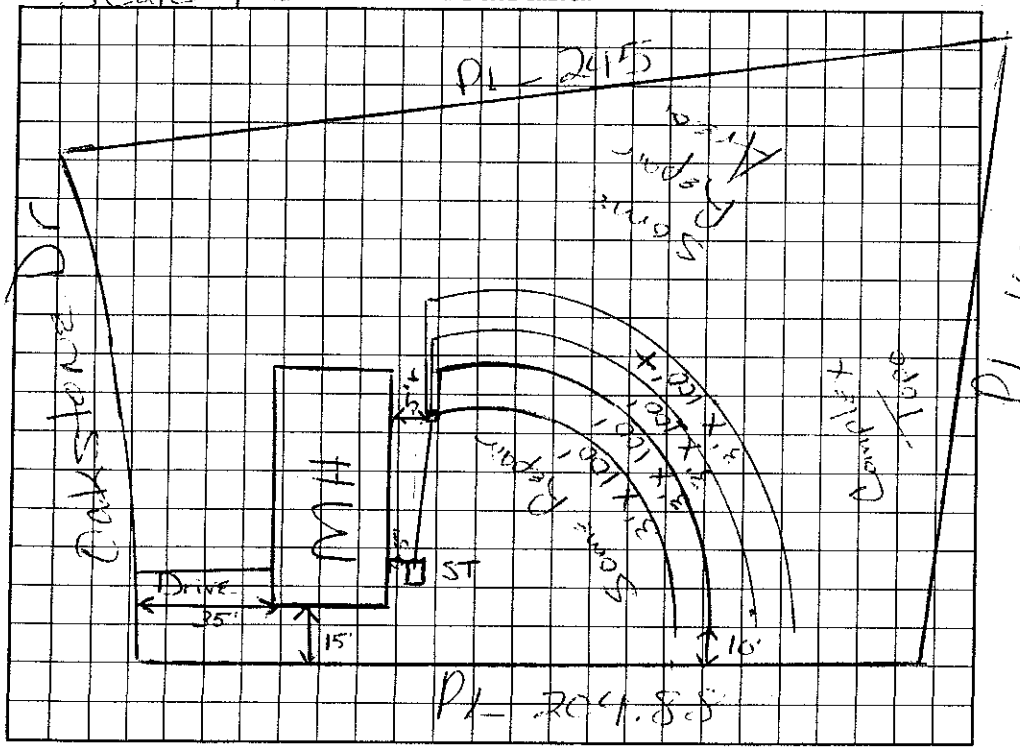

AS BUILT SKETCH

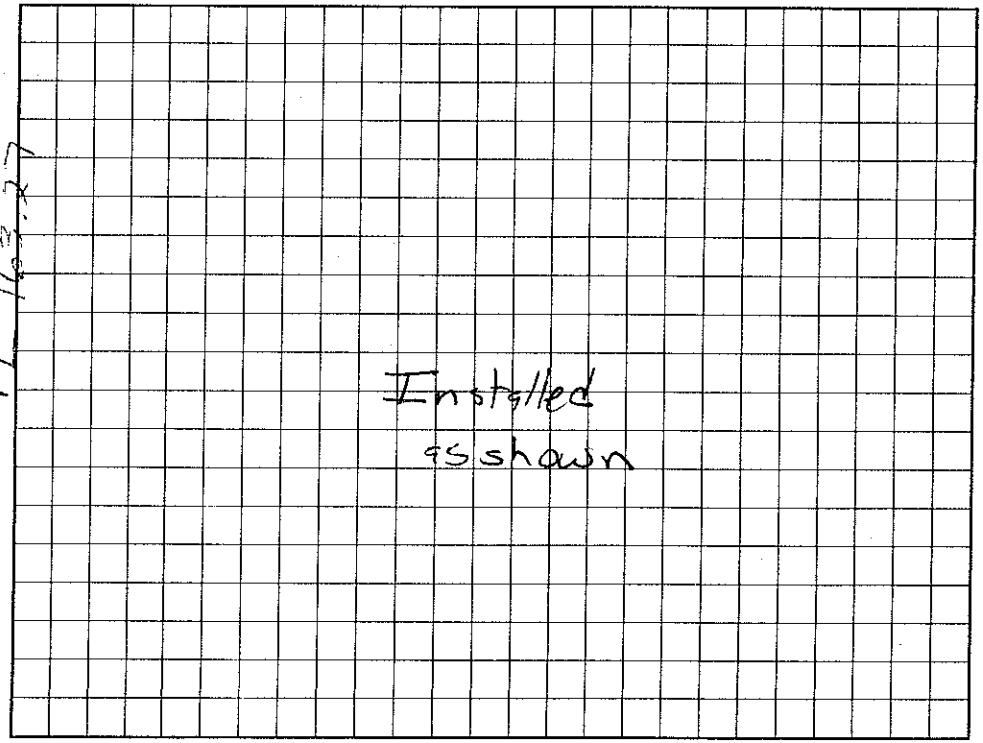

I understand that this permit can be suspended or revoked if any false information is supplied toward securing the permit/any unauthorized changes are made to the site/any unauthorized changes are made in the installation of the system. Improvement Permit with plat valid without expiration. Improvement Permit with site plan valid for sixty months. Authorization to Construct is valid for a period equal to that of Improvement Permit – not to exceed sixty months.

Signed: Jeff Casey agent date 9/18/98
Improvement Permit by: Matthew Dixon date 8/25/98
Authorization to Construct by: date 9/28/99

Installed by: Andy Daniels
Operation Permit by: date 5-28-99
Existing System Inspection by: date

HEALTH DEPT. COPY: WHITE INSPECTION COPY (FINAL): GREEN OWNER COPY (FINAL): YELLOW INSPECTION COPY (INITIAL): PINK OWNER COPY (INITIAL): GOLD