IREDELL COUNTY HEALTH DEPARTMENT

Statesville Office (704) 878-5305 Mooresville Office (704) 660-3625

IMPROVEMENT PERMIT / AUTHORIZATION TO CONSTRUCT / OPERATION PERMIT / EXISTING SYSTEM

PERMIT # 201023

PIN # 4703120903

APPLICANT: Darrell Williams

APPLICANT ADDRESS: 3627 Hickory Hwy

SITE ADDRESS: 3627 Hickory Hwy

PHONE: 704-902-7675 ALT. PHONE: N/A

SITE DIRECTIONS: Hwy 70W, Property on left ~ 2½ past Old Mtn Rd.

SUBDIVISION: Meadow Creek

SECTION: 1 LOT # LOT AREA: 1.58 acres DESIGN FLOW: 360 gpd L.T.A.R.: 0.25


Septic Tank	1000 (gal)	STB	160-1000	Date	1-13-14	☐ New System ☑ Repair ☐ Expansion	System Type: I II (III) IV V VI
Pump Tank	(gal)	PT		Date		System Description:	
Pump Make		Model		Serial #		Repair System Description:	25% Reduction
# Nitrification Fields	1	# Lines	4	Linear Ft:	360	Maintenance Agreement Required:	☐ YES ☑ NO
Trench Width	36"	Max. Trench Bottom Depth	36"	Gravel Depth	N/A	☑ GRAVITY	☐ PRESSURE

☑ Residence No. Bedrooms 3
☐ Business No. Persons 6
☐ Other No. Employees
☐ Slab ☐ Crawl Space
☑ Basement w/plumbing ☐ Basement w/o plumbing

Water Supply
☐ Private
☑ Public
☐ Community

Comments / Conditions: Install a 25% Reduction System on contour with serial distribution. Set new septic tank at location specified below. Pump & crush existing septic tank

INITIAL SITE SKETCH

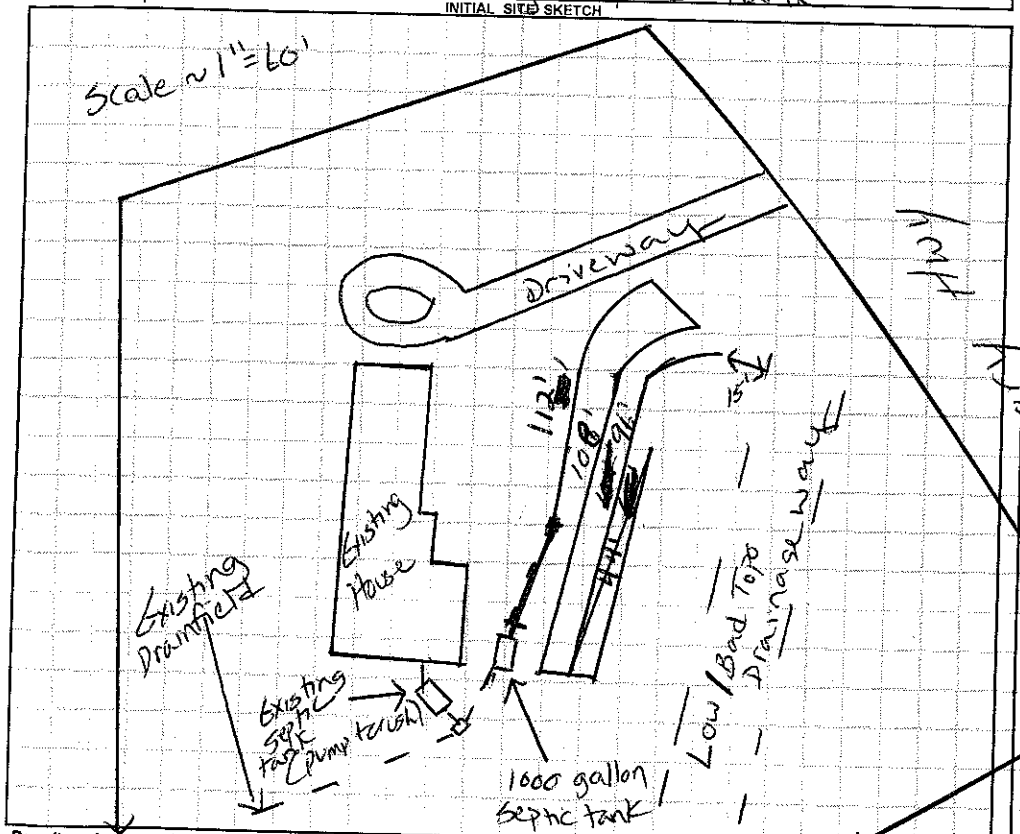

AS BUILT SKETCH

- Red Polylok filter installed
- 2" PVC tank marker installed
- Quick 4 Chambers installed
- Installed as drawn

Permit can be suspended or revoked if any false information is supplied toward securing the permit / any unauthorized changes are made to the site / any unauthorized changes are made in the installation of the system. **CONTACT A LOCATOR SERVICE PRIOR TO ANY EXCAVATION**

☐ **IMPROVEMENT PERMIT** ***with plat*** *valid without expiration.* ☑ **IMPROVEMENT PERMIT** ***with site plan*** *valid for 60 mos.* ☑ **AUTHORIZATION TO CONSTRUCT** *valid for period equal to IMPROVEMENT PERMIT--not to exceed 60 mo.*

Owner / Applicant Signature: Darrell Williams Date:

IMPROVEMENT PERMIT by: Justin Henderson Date: 2-5-14

AUTHORIZATION TO CONSTRUCT by: Justin Henderson Date: 2-5-14

Installed by: Catheran & Son

OPERATION PERMIT by: Justin Henderson Date: 4-25-14

Existing System Inspected by: Date:

Health Dept. Copy - WHITE Applicant (Final Approval) - YELLOW Applicant (Conditional Approval) - PINK