704 598 8800 owner

IREDELL COUNTY HEALTH DEPARTMENT

STATESVILLE 704-878-5305 MOORESVILLE 704-664-5281

IMPROVEMENT PERMIT / AUTHORIZATION TO CONSTRUCT / OPERATION PERMIT / EXISTING SYSTEM INSPECTION

PERMIT# 071418 PIN# 3792268055 DATE 9/3/98

OWNER OR CONTRACTOR Peeks Inc PHONE: Business 567-9536 Home

ADDRESS 5201 Monroe Rd Charlotte, NC 28205

LOCATION Hwy 16 W to Hidden Brook on left at intersection with Oakslope Dr

SUBDIVISION Meadowcreek BLOCK / SECTION II LOT 48 LOT AREA .79 acre SITE CLASS PS DESIGN FLOW 360 gpd L.T.A.R. .3

Septic Tank: 1000 Gallons; STB 1012 Date 12-20-98
Pump Tank: 1000 Gallons; PT 17 Date 12-25-98
Pump Make: HYDROMATIC Model SK60AI Serial No.
Nitrification Field: No Fields 1 Square Feet 1200' Linear Feet 400'
No Lines 3 at 133'ea Trench Width 36" Max Trench Bottom Depth 32" Gravel Depth 12"

[X] New System [ ] Repair System Type: I, II, III, V, V, VI
System Description: Pump-(Pol) - Conventional
Repair System Description: Pump - 25% Reduction
Maintenance Agreement Required: [ ] Yes [X] No

[ ] House/Mod. Home [X] Mobile Home [ ] Business [ ] Other
No. Bedrooms 3 No. Bathrooms 2 No. Employees

[ ] Slab [X] Crawl Space [ ] Basement w/plumbing [ ] Basement wo/plumbing


Water Supply: [ ] Individual [X] Public [ ] Community

Comments:/Conditions: Keep Septic System at least 10' From PL & 5' From House.
Note: Installer may bring Supply line around other side of house; use Quatite ira pipe if subject to vehicular traffic

Comments:/Conditions: See Attached sheets for Pump Tank + Pressure manifold set up which become part of this Permit.

INITIAL SITE SKETCH

Scale: 1:50

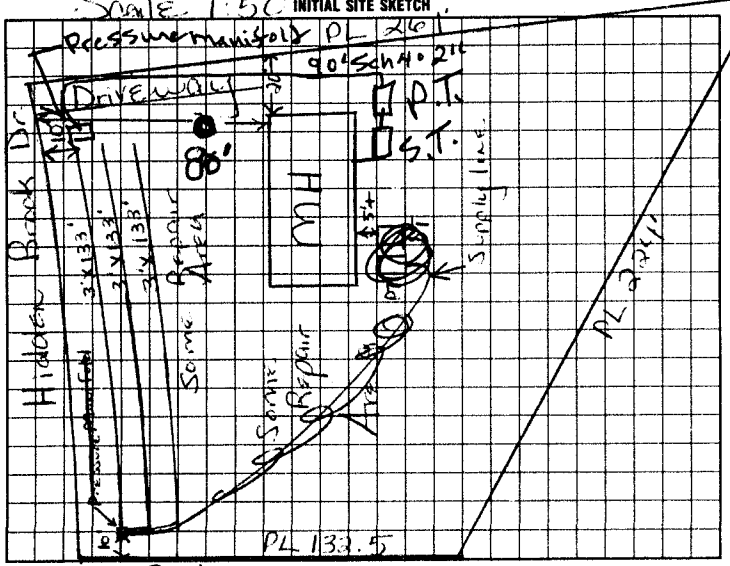

AS BUILT SKETCH

TANKS AND DRAINFIELD INSPECTED 2-9-99 KSH
Cycled pump 3-17-99 Water line ran thru system, Plumbing hooked to wrong tank

I understand that this permit can be suspended or revoked if any false information is supplied toward securing the permit/any unauthorized changes are made to the site/any unauthorized changes are made in the installation of the system. Improvement Permit with plat valid without expiration. Improvement Permit with site plan valid for sixty months. Authorization to Construct is valid for a period equal to that of Improvement Permit – not to exceed sixty months.

Signed: Jeff Casey agent date 9/18/98 Installed by: A-1 Backhoe

Improvement Permit by: Marian H. Fitzsimmons date 9/3/98 Operation Permit by: Mark Cody IO date 4-19-99

Authorization to Construct by: E. C. Moore date 12-17-98 Existing System Inspection by: date

HEALTH DEPT. COPY: WHITE INSPECTION COPY (FINAL): GREEN OWNER COPY (FINAL): YELLOW INSPECTION COPY (INITIAL): PINK OWNER COPY (INITIAL): GOLD