IREDELL COUNTY HEALTH DEPARTMENT

STATESVILLE 704-878-5305 MOORESVILLE 704-664-5281

IMPROVEMENT PERMIT / AUTHORIZATION TO CONSTRUCT / OPERATION PERMIT / EXISTING SYSTEM INSPECTION

PERMIT# 07141 PIN# 3792326855 DATE 8/31/98

OWNER OR CONTRACTOR ~~Peek's Inc~~ Howard M. Hill PHONE: Business 547-9536 Home

ADDRESS 5201 Monroe Rd Charlotte NC 28205

LOCATION Hwy 70W TL Hidden Brook TL Oakstone lot immediately on left

SUBDIVISION Meadowbrook BLOCK / SECTION II LOT 41 LOT AREA 1.54 Acre SITE CLASS. PS DESIGN FLOW 360 gpd L.T.A.R. .23

Septic Tank: 1000 Gallons; STB 786 Date 6 30 98
Pump Tank: ____ Gallons; PT ____ Date ____
Pump Make: ____ Model ____ Serial No. ____
Nitrification Field: No Fields 1 Square Feet *900 Linear Feet 300'
No Lines 4 at 75' Trench Width 36" Max Trench Bottom Depth 36" Gravel Depth N/A

☐ New System ☐ Repair System Type: I, II, III, IV, V, VI
System Description: Gravity -- 25% Reduction
Repair System Description: Pump/Gravity Modified
Maintenance Agreement Required: ☐ Yes ☒ No

☐ House/Mod. Home ☒ Mobile Home ☐ Business ☐ Other
No. Bedrooms 3 No. Bathrooms 2 No. Employees ____


☐ Slab ☒ Crawl Space ☐ Basement w/plumbing ☐ Basement wo/plumbing

Water Supply: ☐ Individual ☒ Public ☐ Community


Comments:/Conditions: * 25% Reduction in Drainfield Area
Keep Septic System at least 5' from House & 10' from PL

Comments:/Conditions: HDS Sections used E 722 Cay

Scale 1:50' **INITIAL SITE SKETCH**

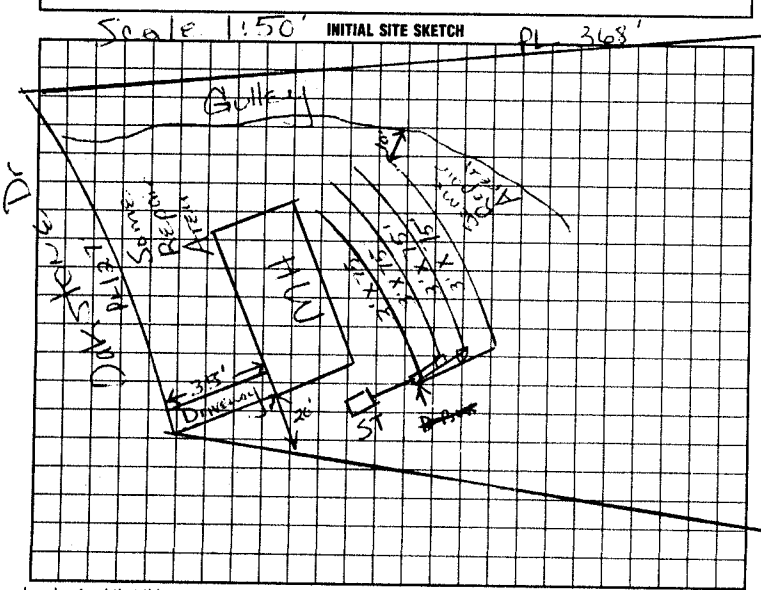

AS BUILT SKETCH

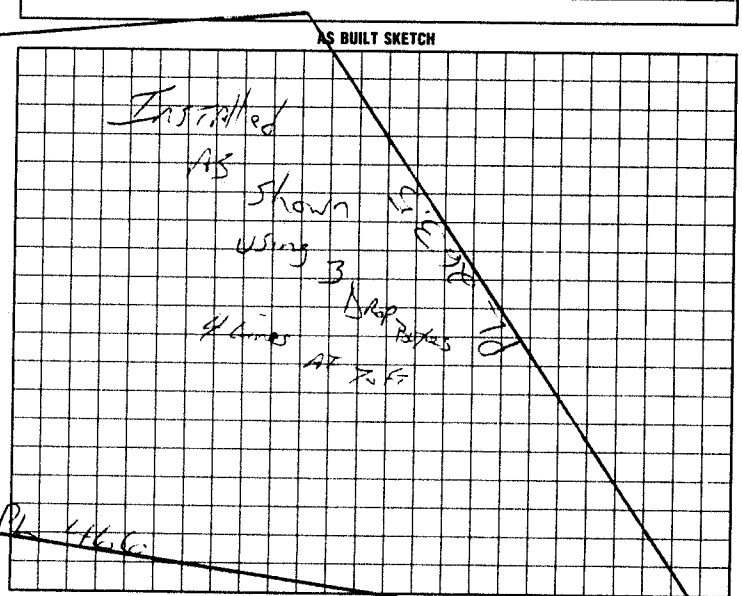

I understand that this permit can be suspended or revoked if any false information is supplied toward securing the permit/any unauthorized changes are made to the site/any unauthorized changes are made in the installation of the system. Improvement Permit with plat valid without expiration. Improvement Permit with site plan valid for sixty months. Authorization to Construct is valid for a period equal to that of Improvement Permit – not to exceed sixty months.

Signed: Jeff Casey agent date 9/18/98
Improvement Permit by: Maya Hill Eaton date 8/31/98
Authorization to Construct by: J.C. Moore date 9/1/98

Installed by: Catawba Septic
Operation Permit by: [illegible] date 9 10 98
Existing System Inspection by: ____ date ____

HEALTH DEPT. COPY: WHITE INSPECTION COPY (FINAL) GREEN OWNER COPY (FINAL) YELLOW INSPECTION COPY (INITIAL) PINK OWNER COPY (INITIAL) GOLD