IREDELL COUNTY HEALTH DEPARTMENT

STATESVILLE 704-878-5305 MOORESVILLE 704-664-5281

IMPROVEMENT PERMIT / AUTHORIZATION TO CONSTRUCT / OPERATION PERMIT / EXISTING SYSTEM INSPECTION

PERMIT # Repair PIN # 4703-13-2591 DATE 19 March 09

OWNER or APPLICANT Billy Ellenburg PHONE: Business Home: 704-872-2638

OWNER or APPLICANT ADDRESS 3598 Hickory Highway

LOCATION / DIRECTIONS I 40 WTR old mtn. Rd. - TL old mtn. Rd. TR Hwy 70W 4th House in Rt. past Bearfield Rd.

SUBDIVISION BLOCK / SECTION LOT # LOT AREA DESIGN FLOW L.T.A.R.

Septic Tank Exist Gallons: STB Date

Pump Tank Gallons: PT Date

Pump Make Model Serial #

Nitrification Field No Fields 1 No Lines 3 Linear Feet 200

Trench Width 36" Max. Trench Bottom Depth 36" Gravel Depth NA

☐ New System ☑ Repair ☐ Expansion System Type I II III IV V VI

System Description: 2580 Reduction

Repair System Description:

Maintenance Agreement Required ☐ YES ☑ NO

☑ GRAVITY ☐ PRESSURE

☑ Residence No. Bedrooms 3

☐ Business No. Persons

☐ Other No. Employees

☐ Slab ☐ Crawl Space

☑ Basement w/plumbing ☐ Basement w/o plumbing

Water Supply: ☑ Private ☐ Public ☐ Community


Comments / Conditions

Comments / Conditions

INITIAL SITE SKETCH

Please see Attached site sketch.

AS BUILT SKETCH

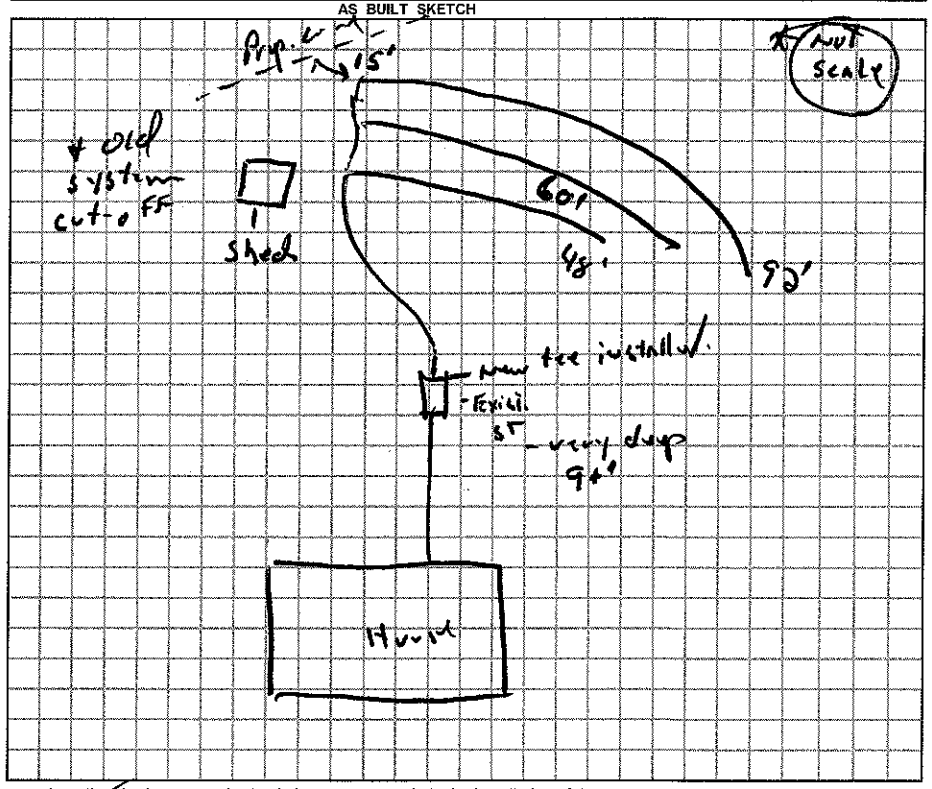

Permit can be suspended or revoked if any false information is supplied toward securing the permit / any unauthorized changes are made to the site / any unauthorized changes are made in the installation of the system.

☐ *IMPROVEMENT PERMIT w / plat valid without expiration* ☑ *IMPROVEMENT PERMIT w / site plan valid for 60 mos.* ☑ *AUTHORIZATION TO CONSTRUCT valid for period equal to IMPROVEMENT PERMIT-not to exceed 60 mo.*

Owner / Applicant Signature: Billy Ellenburg Date 19 March 09

Improvement Permit by: R.S. Date 19 March 09

Authorization to Construct by: R.S. Date 19 March 09

YOU SHOULD CONTACT A LOCATOR SERVICE PRIOR TO ANY EXCAVATION.

Installed by: A-1

Operation Permit by: R.S. Date: 20 March 09

Existing System Inspected by: Date:

WHITE COPY Environmental Health YELLOW COPY (Final) Owner / Applicant PINK COPY (Initial) Owner / Applicant