IREDELL COUNTY HEALTH DEPARTMENT

STATESVILLE 704-878-5305 MOORESVILLE 704-664-5281

IMPROVEMENT PERMIT / AUTHORIZATION TO CONSTRUCT / OPERATION PERMIT / EXISTING SYSTEM INSPECTION

PERMIT# REPAIR PIN# DATE 1-8-01

OWNER OR CONTRACTOR EARL P. TUCKER PHONE: Business Home 873-8620

ADDRESS 3607 Hickory Hwy, Statesville, NC 28677

LOCATION US 70 WEST, House on LEFT AT Box # 3607

SUBDIVISION BLOCK / SECTION LOT LOT AREA Ample SITE CLASS PS DESIGN FLOW 360 L.T.A.R. 0.30 GPD/FT²

Septic Tank: EXISTING Gallons: STB Date

Pump Tank: Gallons: PT Date

Pump Make: Model Serial No.

Nitrification Field: No Fields 1 Square Feet 360 Linear Feet 120

No Lines TWO Trench Width 36" Max Trench Bottom Depth 36" Gravel Depth (18")

☐ New System ☑ Repair System Type: I (II) III, IV, V, VI

System Description:

Repair System Description: CONV. GRAVITY

Maintenance Agreement Required: ☐ Yes ☑ No

☐ Slab ☐ Crawl Space ☑ Basement w/plumbing ☐ Basement wo/plumbing

☑ House/Mod. Home No. Bedrooms 3

☐ Mobile Home No. Bathrooms 1½

☐ Business No. Employees


☐ Other

Water Supply: ~~☐ Individual~~ ☑ Public ☐ Community


Comments/Conditions: ① INSTALL NEW SUPPLY LINE AS SHOWN ② INSTALL NEW DROP BOX FEEDING BOTH NEW AND OLD LINES, ③ INSTALL NEW SANITARY TEE

Comments/Conditions:

INITIAL SITE SKETCH

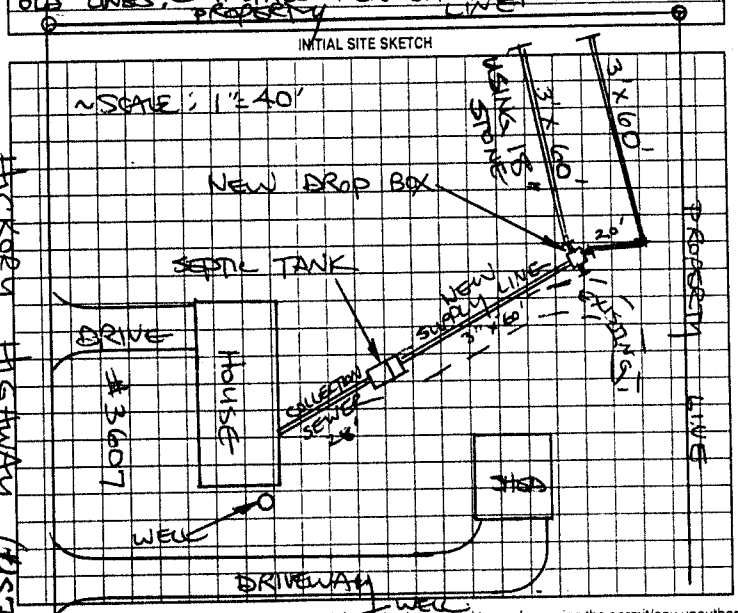

AS BUILT SKETCH

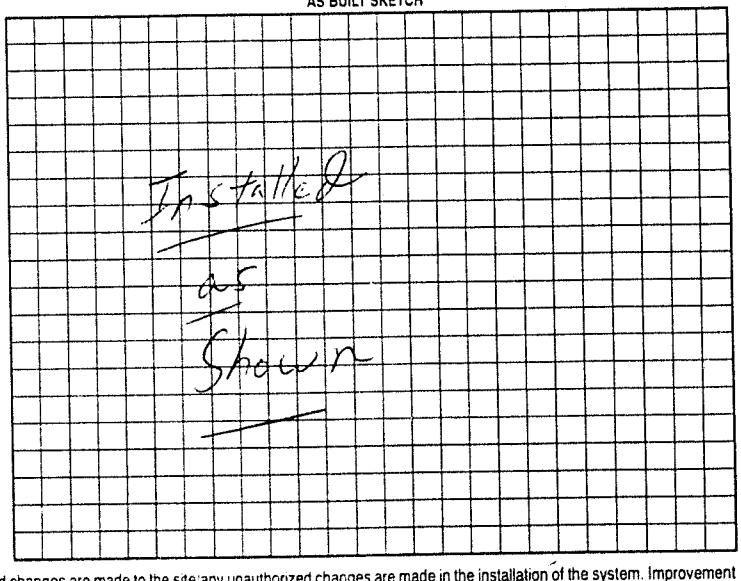

Permit can be suspended or revoked if any false information is supplied toward securing the permit/any unauthorized changes are made to the site/any unauthorized changes are made in the installation of the system. Improvement Permit with plat valid without expiration. Improvement Permit with site plan valid for sixty months. Authorization to Construct is valid for a period equal to that of Improvement Permit – not to exceed sixty months.

Signed: Earl Tucker date 1-8-01 Installed by: Esker Elder

Improvement Permit by: STEVE HENDRICK date 1-8-01 Operation Permit by: William A. Johnson RSI date 3-12-01

Authorization to Construct by: STEVE HENDRICK date 1-8-01 Existing System Inspection by: date

HEALTH DEPT COPY WHITE OWNER COPY (FINAL) YELLOW OWNER COPY (INITIAL) PINK