IREDELL COUNTY HEALTH DEPARTMENT

Statesville Phone TR 3-7271 — Mooresville Phone NO 3-1271

PERMIT TO INSTALL SEPTIC TANK

Permit No. _____ Permit Date 1-10 19 64

Owner JERRY FISHER Address R.F.D. 3 STATESVILLE N.C.

Installed By BILL MARTIN Address _____


Location of Property OFF FD 3 WEST JUST BEYOND TOM WILSON'S GRO LEFT (PRIVATE DRIVE)

Tank		Capacity		Length of Lines		Fixtures	
Block	( )	1000	( )	225'	( )	No. of Baths	(1)
Precast	(✓)	1250	( )	250'	( )	Dishwasher	( )
		1500	( )	Other _____		Garbage Grdr.	( )
		Other _____				Other _____	

NOTIFY HEALTH DEPARTMENT AT LEAST EIGHT HOURS BEFORE TANK IS TO BE INSPECTED.

Final Inspection 1-10 19 64 Approved (✓) Disapproved ( )

Remarks _____

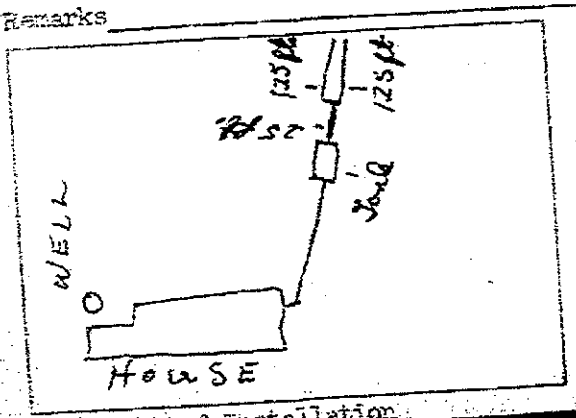

Sketch of Installation

Sanitarian

Repair William S. Miller

MAY. 26, 19;5 1:01