IREDELL COUNTY HEALTH DEPARTMENT

Statesville Phone TR 3-7271 Mooresville Phone NO 3-1271

PERMIT TO INSTALL SEPTIC TANK

Permit No. 177 Permit Date 4-5- 1972

Owner Earnest Beaver Address Statesville N.C.

Installed By Robert Boost. Address " " "


Location of Property off Hiway 64 turn Right at wilson store

Tank		Capacity		Length of Lines		Fixtures	
Block	( )	1000	( )	225'	( )	No. of Baths	( )
Precast	( )	1250	( )	250'	( )	Dishwasher	( )
		1500	( )	Other		Garbage Grdr.	( )
		Other				Other	

NOTIFY HEALTH DEPARTMENT AT LEAST EIGHT HOURS BEFORE TANK IS TO BE INSPECTED.

Final Inspection 19 Approved ( ) Disapproved ( )

Remarks Repair old system Installed 150ff New Lines and connected to old ones

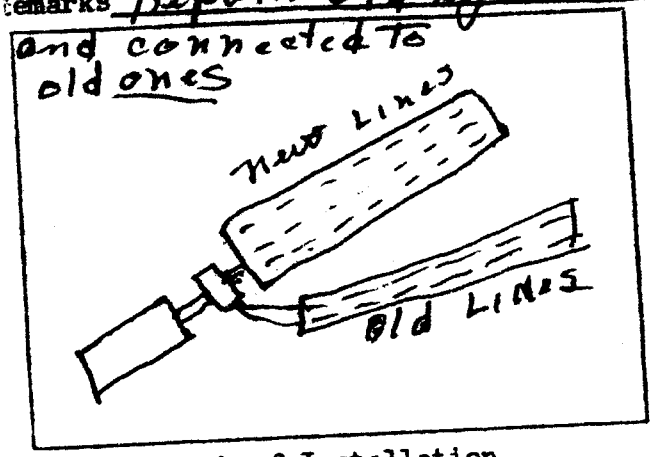

Sketch of Installation

Not checked -

Sanitarian

To Mr R.W. Johnson. P.S