ICHD - ENVIRONMENTAL HEALTH DIVISION

Statesville Office (704) 878-5305 x3456 Mooresville Office (704) 660-3625

SEPTIC: IMPROVEMENT PERMIT / AUTHORIZATION TO CONSTRUCT / OPERATION PERMIT / EXISTING SYSTEM

PERMIT : OSWP- 2024- 50256

PIN # 4703 - 15 - 3352

APPLICANT/OWNER: SHANE HAFFEY SR. APPLICANT ADDRESS: 125 CHESTNUT TREE ROAD, MOORESVILLE, N.C. 28117

SITE ADDRESS: 186 BENFIELD ROAD, STATESVILLE, N.C. 28677 PHONE: 704-608-1358 ALT. PHONE –

SITE DIRECTIONS: (W) ON 70, (R) ON BENFIELD ROAD, LOT ON (R) SAP CONTROLLED: ☐ YES ☐ NO EXT

SUBDIVISION: – SECTION: – LOT # – LOT AREA: 2.13AC DESIGN FLOW: EXT L.T.A.R.(Initial): EXT L.T.A.R (Repair): EXT

Septic Tank	1000 (gal)	STB		Date		☐ New System	☑ Repair	☐ Expansion	System Type: I (II) III IV V VI
Pump Tank	– (gal)	PT	–	Date	–	System Description:	EXISTING - COVENTIONAL		
Pump Make	–	Model	–	Serial #	–	Repair System Description:	TANK REPLACEMENT		
# Nitrification Fields	EXT	# Lines	EXT	Linear Ft	EXT	Maintenance Agreement Required:	☐ YES	☑ NO	
Trench Width	EXT	*Max. Trench Depth(Initial)	EXT	*Max. Trench Depth(Repair)	EXT	Gravel Depth	EXT	☑ GRAVITY	☐ PRESSURE


* Measured on the downhill side of the trench Effluent Standard: ☑ DSE ☐ HSE ☐ TS-I ☐ TS-II ☐ RCW ☐ NSF/ANSI 40 Usable Depth to LC (Initial): EXT

☑ Residence	No. Bedrooms	EXT	**Water Supply**
☐ Business	No. Persons	EXT	☐ Private
☐ Other	No. Employees	–	☑ Public
☐ Slab	☑ Crawl Space		☐ Community
☐ Basement w/plumbing			☐ Basement w/o plumbing

Usable Depth to LC (Repair): EXT *Limiting Condition*

Comments / Conditions: PUMP, CRUSH, AND FILL EXISTING SEPTIC TANK, WATER LINE MUST BE EXPOSED AT TIME OF INSTALL TO VERIFY SETBACK, DRAINFIELD APPEARED TO BE FUNCTIONING AT TIME OF INSPECTION

INITIAL SITE SKETCH

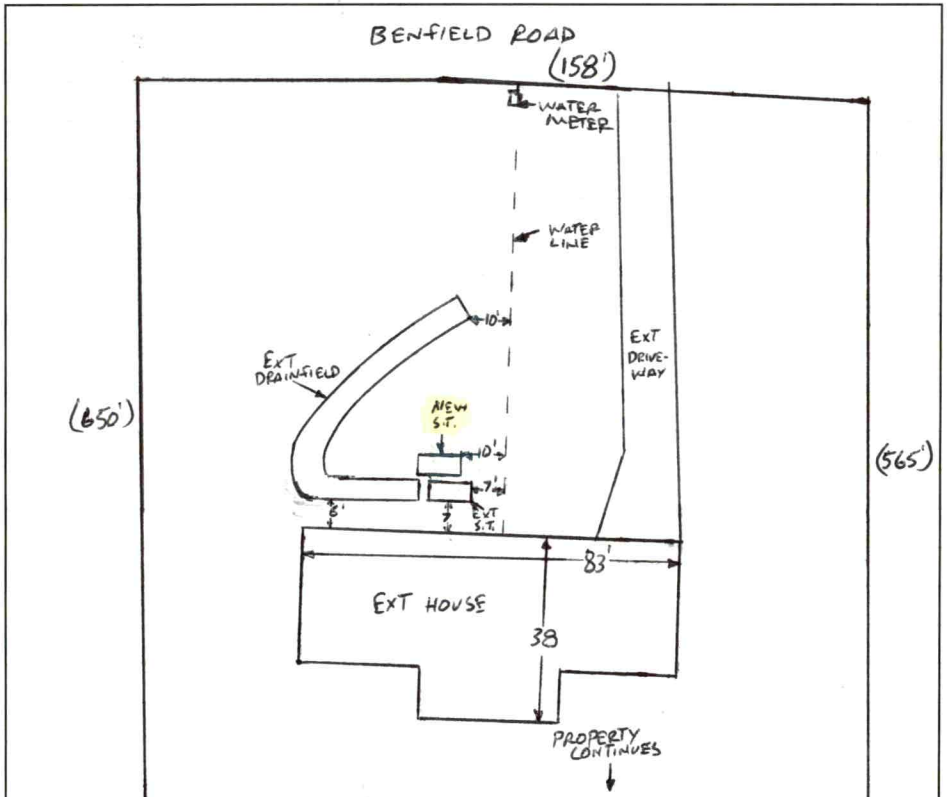

AS BUILT SKETCH

FOR SEPTIC FINAL INSPECTION CALL: 704-664-3703 between 8am-9am

the day the inspection is needed. Be sure to speak with an inspector to confirm your time.

Installed as drawn.

1 IN = 40 ft
S.T. = SEPTIC TANK
EXT = EXISTING

Permit can be suspended or revoked if any false information is supplied toward securing the permit / any unauthorized changes are made to the site / any unauthorized changes are made in the installation of the system. **CONTACT A LOCATOR SERVICE PRIOR TO ANY EXCAVATION**

☐ **IMPROVEMENT PERMIT** ***with plat*** *valid without expiration.* ☑ **IMPROVEMENT PERMIT** ***with site plan*** *valid for 60 mos.* ☑ **AUTHORIZATION TO CONSTRUCT** *valid for period equal to IMPROVEMENT PERMIT--not to exceed 60 mo.*

Owner / Applicant Signature: ONLINE SIGNATURE Date: – Installed by: Piedmont Septic Solutions

IMPROVEMENT PERMIT by: Bryant C. White Date: 4-9-2024 OPERATION PERMIT by: Shane Williams Date: 4/22/2024

AUTHORIZATION TO CONSTRUCT by: Bryant C. White Date: 4-9-2024 Existing System Inspected by: Date:

Item	Date	Initials
Drain Lines Checked		
Tanks Checked		
Pressure Manifold or Valve Box Checked		
Pressure Head Set		
Electrical Checked		
Floats Set		
Alarm Checked		
Maintenance Contract Needed? Y / N		
Comments:		

Repairs Only	
	State Code
Failing System Code	
Type of Distribution	G or P
Type of Failure/Malfunction	
Primary Cause of Failure/Malfunction	
Age of System? _____	
Initial or Repair? _____	


565
650
607
4703-15-1366
4703-15-3352
186
St inlet
St outlet
4703-15-5218
66
82
176
158
Benfield Rd
138
4703-14-2756
1in = 40 ft

PERMIT SNAPSHOT REPORT OSWP-2024-50256 FOR IREDELL COUNTY

Permit Type	Environmental Health OSWP	**Project:**		**App Date:**	04/01/2024
Work Class:	EH Septic Permit	**District:**	Iredell County	**Exp Date:**	NOT AVAILABLE
Status:	PRIORITY PERMIT	**Square Feet:**	0.00	**Completed:**	NOT COMPLETED
Valuation:	$0.00	**Assigned To:**	White, Bryant	**Approval Expire Date:**	
Description:	Repair Permit				

Parcel: 4703153352.000 Main	**Address:** 186 Benfield Rd Statesville, NC 28677 Main	**Zone:** R-20(Suburban Residential District)

Applicant/Authorized Agent
Justine Brawley
736 Brawley School Rd. Suite A
Mooresville, NC 28166

Property Owner
SHANE SR+TRICIA A
LANDTISER HAFFEY HAFFEY
125 CHESTNUT TREE RD.
MOORESVILLE, NC 28117
Business: (704) 608-1358

Permit Custom Fields


How is your site plan being submitted	Custom Site Plan	Septic Application/Permit Type	Repair	Does the site contain any jurisdictional wetlands	No
Non-domestic Sewage Generated	No	Other Public Agency	No	All proposed structure dimensions	3 bedroom septic tank 1000 gal
Maximum Number of Bedrooms	3	If other Addition/Structure, please explain		Number of Occupants	6
Foundation Type	Crawl Space Foundation	Residential/Business/Other	Residential	Water Supply	Municipal Water
Desired Septic System Type	Conventional (most common)	Additional Unique Setbacks Apply	No		

Attachment File Name	Added On	Added By	Attachment Group	Notes
Signature_Justine_Brawley_4/1/2024.jpg	04/01/2024 10:24	Brawley, Justine		Uploaded via CSS
Documentation to Authoirize_v1.pdf	04/01/2024 10:30	Brawley, Justine	Available Online	

Workflow Step / Action Name	Action Type	Start Date	End Date
Application Completeness Check v.1		04/01/2024 10:30	04/01/2024 10:31
Confirm application complete v.1	Generic Action		04/01/2024 10:31
~~**Zoning Review v.1**~~			04/01/2024 10:30
~~Floodplain Admin Overview v.1~~	Task		04/01/2024 10:30
~~Issue Invoice v.1~~	Generic Action		04/01/2024 10:30
~~Fees Paid v.1~~	Generic Action		04/01/2024 10:30
Fees v.1			
Issue Invoice v.1	Generic Action		
Fees Paid v.1	Generic Action		
Lot Readiness Verification v.1			
OSWP Septic Preliminary Site Visit v.1	Inspection		
OSWP Site Evaluation v.1	Inspection		
Issue Improvement Permit v.1			
Issue Invoice v.1	Generic Action		
Fees Paid v.1	Generic Action		
Issue Permit v.1	Generic Action		

PERMIT SNAPSHOT REPORT (OSWP-2024-50256)

Permit Completion Process v.1	
Authorization to Construct Permit v.1	Create Sub Permit
Issue Authorization to Construct v.1	Generic Action

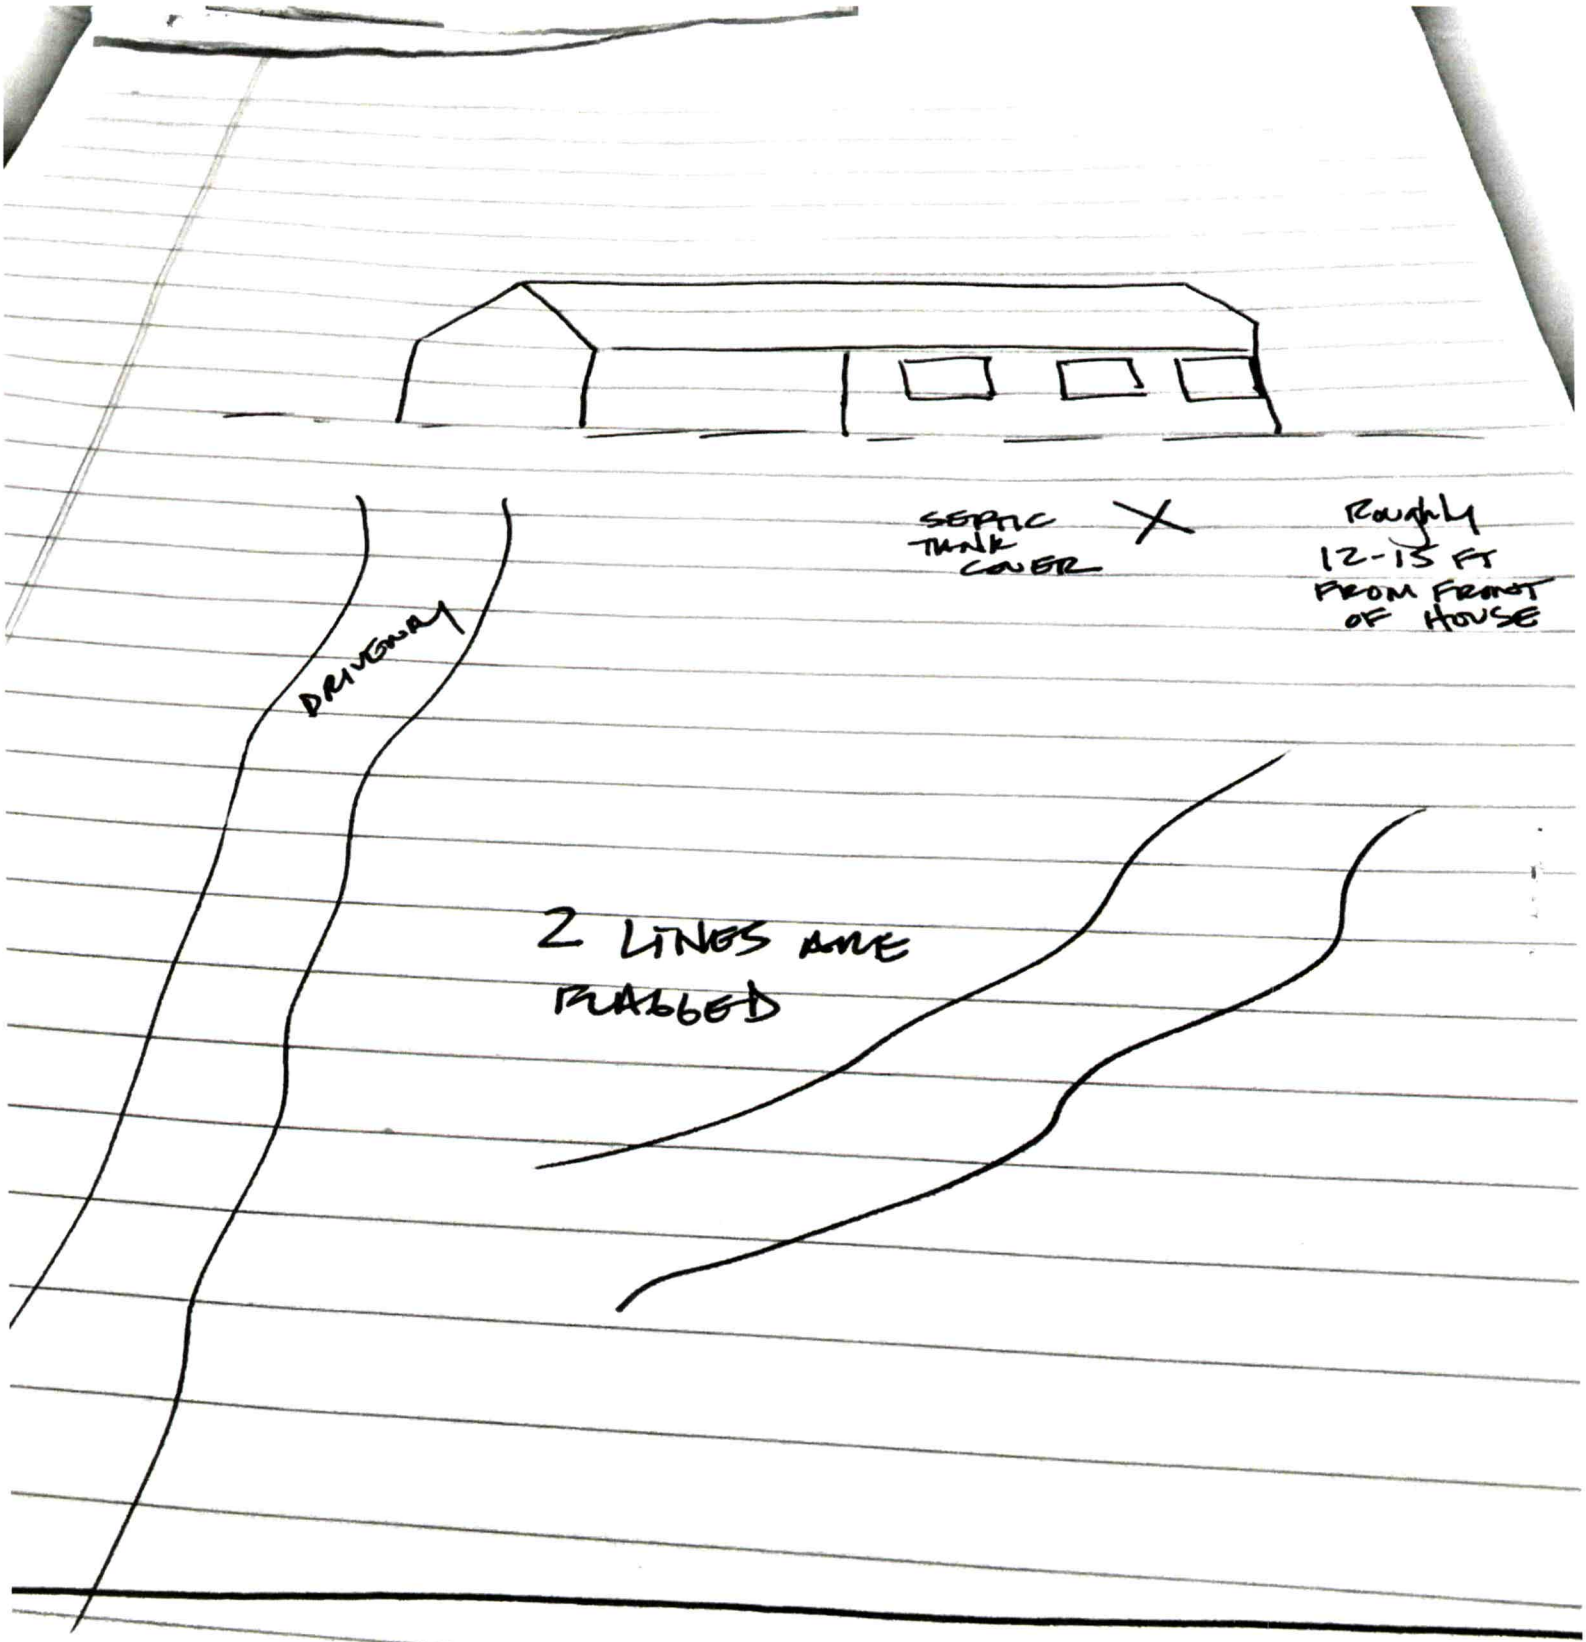
SEPTIC TANK COVER
ROUGHLY 12-15 FT FROM FRONT OF HOUSE
DRIVEWAY
2 LINES ARE FLAGGED
