IREDELL COUNTY HEALTH DEPARTMENT

Statesville Office (704) 878-5305 Mooresville Office (704) 660-3625 PERMIT # 216002

IMPROVEMENT PERMIT / AUTHORIZATION TO CONSTRUCT / OPERATION PERMIT / EXISTING SYSTEM

PIN # 4703-15-8182.000

APPLICANT: Chris Hogan/Jennifer Hogan APPLICANT ADDRESS: 241 Scotts Creek Rd. Statesville NC

SITE ADDRESS: 158 Benfield Rd Statesville NC PHONE: 704-537-8352 ALT. PHONE:

SITE DIRECTIONS: Hickory Hwy N. To Benfield Rd., Site on R

SUBDIVISION: SECTION: — LOT # — LOT AREA: 4.450 Acres DESIGN FLOW: 480 GPD L.T.A.R.: .225

Septic Tank 1000 (gal) STB 1012 Date 6-22-16
Pump Tank (gal) PT Date
Pump Make Model Serial #
Nitrification Fields 1 # Lines 6 Linear Ft: 533'
Trench Width 36" Max. Trench Bottom Depth 18" Lowest Gravel Depth N/A

☒ New System ☐ Repair ☐ Expansion System Type: I II (III) IV V VI
System Description: 25% Reduction - Gravity
Repair System Description: 25% Reduction - Pump
Maintenance Agreement Required: ☐ YES ☒ NO
☒ GRAVITY ☐ PRESSURE

☒ Residence No. Bedrooms 4
☐ Business No. Persons 8
☐ Other No. Employees
☐ Slab ☒ Crawl Space
☐ Basement w/plumbing ☐ Basement w/o plumbing


Water Supply: ☒ Private ☐ Public ☐ Community

Comments / Conditions: Install As Proved. Follow All NC Septic Rules.


Used Quick 4

INITIAL SITE SKETCH

1"=60'

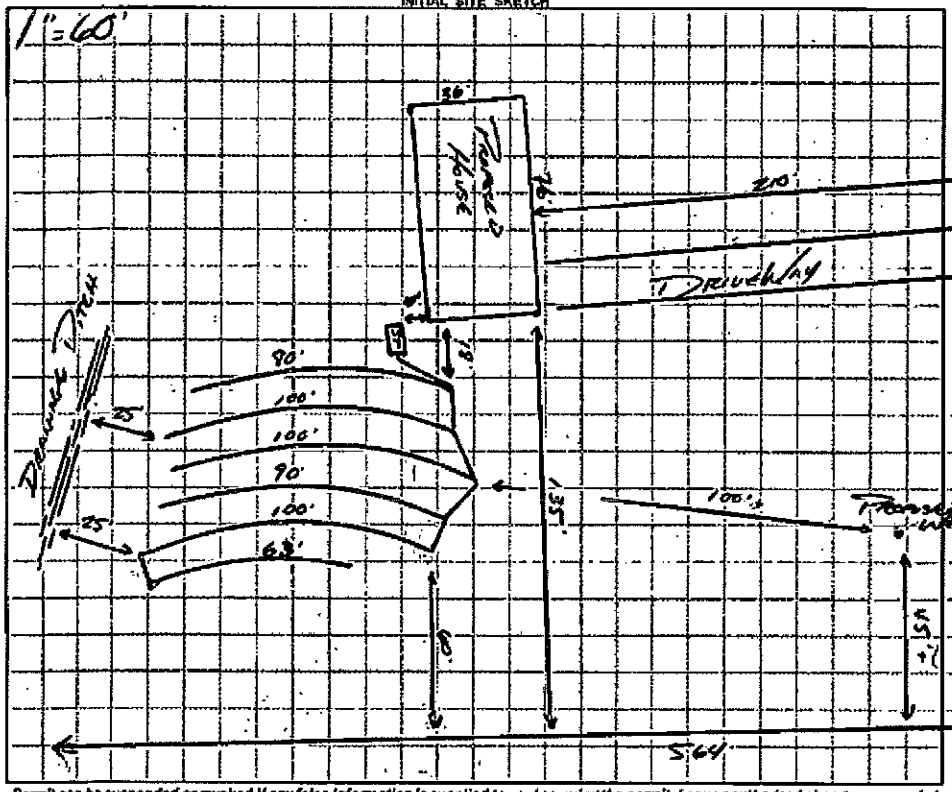

AS BUILT SKETCH

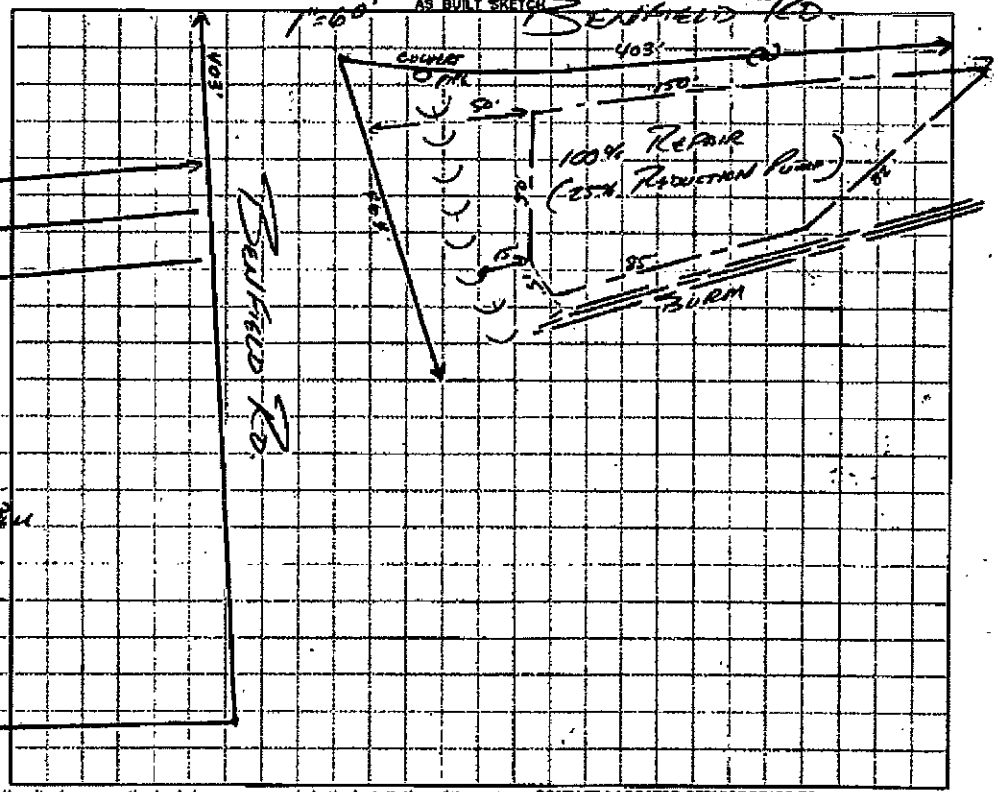

Permit can be suspended or revoked if any false information is supplied toward securing the permit / any unauthorized changes are made to the site / any unauthorized changes are made in the installation of the system. **CONTACT A LOCATOR SERVICE PRIOR TO ANY EXCAVATION**

☐ **IMPROVEMENT PERMIT** *with plat valid without expiration.* ☒ **IMPROVEMENT PERMIT** *with site plan valid for 60 mos.* ☒ **AUTHORIZATION TO CONSTRUCT** *valid for period equal to IMPROVEMENT PERMIT--not to exceed 60 mo.*

Owner / Applicant Signature: Jennifer B Hogan Date: 4-7-16 Installed by: Frye Grading

IMPROVEMENT PERMIT by: APPROVED MAR 21 2016 OPERATION PERMIT by: Angela Dotson Date: 12/9/16

AUTHORIZATION TO CONSTRUCT by: Date: 08/04/16 Existing System Inspected by: Date:

Health Dept. Copy - WHITE Applicant (Final Approval) - YELLOW Applicant (Conditional Approval) - PINK