IREDELL COUNTY HEALTH DEPARTMENT

STATESVILLE 704-878-5305 MOORESVILLE 704-664-5281

IMPROVEMENT PERMIT / AUTHORIZATION TO CONSTRUCT / OPERATION PERMIT / EXISTING SYSTEM INSPECTION

PERMIT# Repair PIN# 4703-17-5231 DATE 2/11/04

OWNER OR CONTRACTOR James H. Piercy PHONE: Business — Home (704) 873-2760

ADDRESS 339 Mock mill Rd Statesville N.C. 28677

LOCATION I-40 W, (L) Old R, (R) Dewlah Ch. Rd., (L) Mock Mill Rd, on left @ 339 Mock mill Rd

SUBDIVISION — BLOCK / SECTION — LOT — LOT AREA Acres SITE CLASS. P5 DESIGN FLOW — L.T.A.R. Ex

Septic Tank Ex 1,000 Gallons; STB — Date —

Pump Tank: — Gallons; PT — Date —

Pump Make: — Model — Serial No. —

Nitrification Field: No Fields Ex Square Feet 750 + 750 Linear Feet 250 + 300

No Lines — Trench Width — Max Trench Bottom Depth — Gravel Depth —

☐ New System ☒ Repair System Type: (I), II, III, IV, V, VI

System Description: —

Repair System Description: Gravity Conv

Maintenance Agreement Required: ☐ Yes ☒ No

☒ House/Mod. Home No. Bedrooms 3

☐ Mobile Home No. Bathrooms 2

☐ Business No. Employees —

☐ Other —


☐ Slab ☐ Crawl Space ☒ Basement w/plumbing ☐ Basement wo/plumbing

Water Supply: ☒ Individual ☐ Public ☐ Community


Comments:/Conditions: (1) Use Existing old System & tie Failing System by adding drop box and Supply line to Ex. Septic Tank as shown (2) Pump Septic tank before doing repair (3) This permit serves as N.O.V. 30 Days to repair System.

Comments:/Conditions: - Two cleanouts installed in new pipe - Repaired as shown Ref: James Piercy (1996) & James Ray (1979)

INITIAL SITE SKETCH

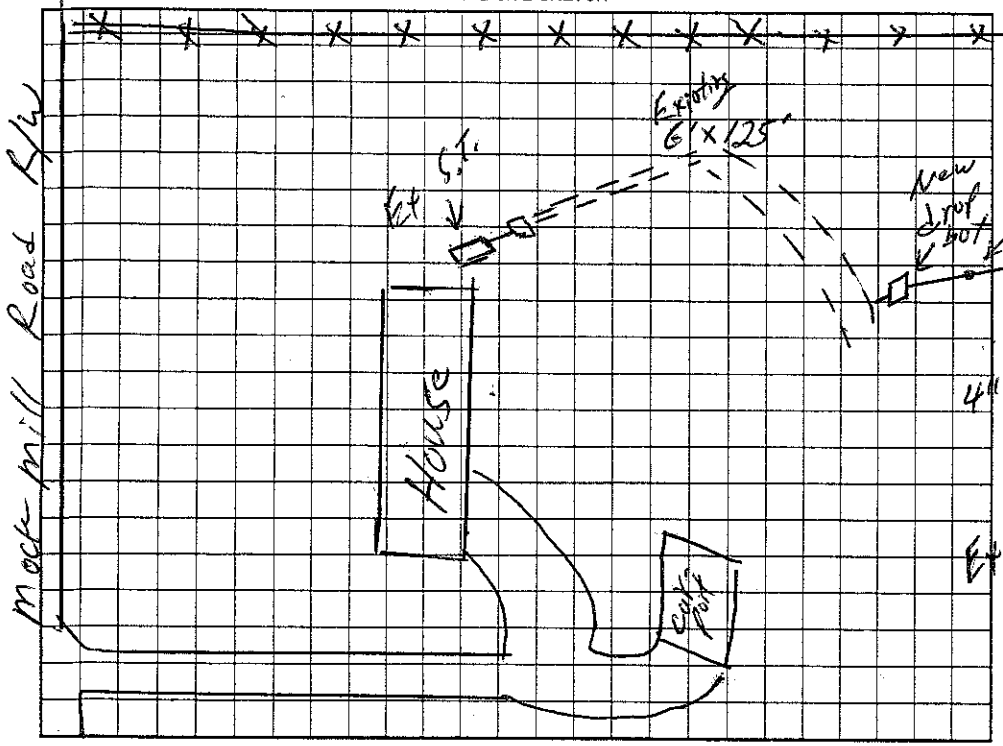

AS BUILT SKETCH

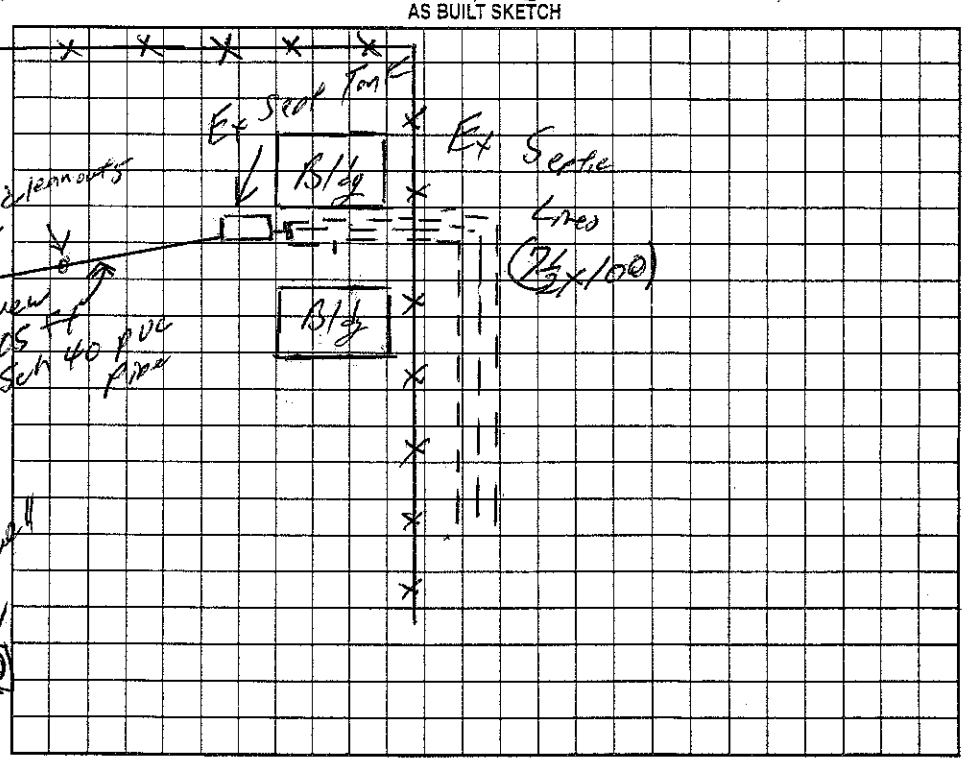

Permit can be suspended or revoked if any false information is supplied toward securing the permit/any unauthorized changes are made to the site/any unauthorized changes are made in the installation of the system. Improvement Permit with plat valid without expiration. Improvement Permit with site plan valid for sixty months. Authorization to Construct is valid for a period equal to that of Improvement Permit – not to exceed sixty months.

Signed: James H. Piercy date 2/11/04

Improvement Permit by: William O. Johnson date 2/11/04

Authorization to Construct by: William O. Johnson date 2/11/04

Installed by: Wes Lytton

Operation Permit by: William O. Johnson date 3/4/04

Existing System Inspection by: — date —

HEALTH DEPT. COPY: WHITE OWNER COPY (FINAL): YELLOW OWNER COPY (INITIAL): PINK