IREDELL COUNTY HEALTH DEPARTMENT

Statesville Phone TR 3-7271 Mooresville Phone NO 3-1271

PERMIT TO INSTALL SEPTIC TANK

Permit NO. 60 Permit Date 8-14 1972

Bldr.

Owner Edmiston - Brinkley Address Statesville, NC

Installed By Lackey Bros. Address Stony Point, N.C.


Location of Property 1-40 - Left on Old Mt. Rd - Right on Rd # 1510 - To Rd # 1505 - Go 1 mile. House on Left.

| Tank | | Capacity | | Length of Lines | | Fixtures | |
|---|---|---|---|---|---|---|---|
| Block | ( ) | 1000 | (✓) | 225' | (✓) | No. of Baths | (2½) |
| Precast | (✓) | 1250 | ( ) | 250' | ( ) | Dishwasher | ( ) |
| | | 1500 | ( ) | Other | | Garbage Grdr. | ( ) |
| | | Other | | | | Other | |

NOTIFY HEALTH DEPARTMENT AT LEAST EIGHT HOURS BEFORE TANK IS TO BE INSPECTED.

Final Inspection 8-14 1972 Approved (✓) Disapproved ( )

Remarks

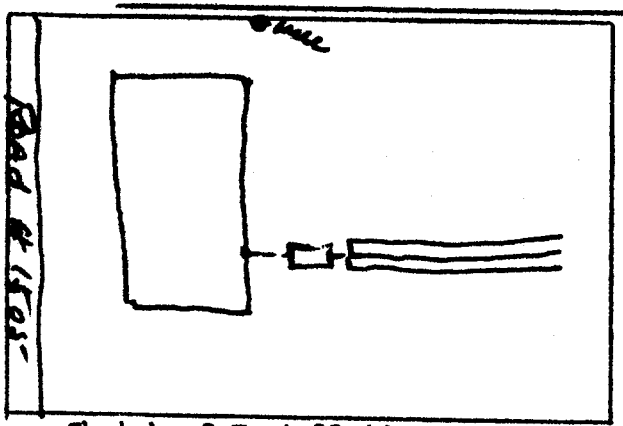


Sketch of Installation

Glenn Lackey

Sanitarian