IREDELL COUNTY HEALTH DEPARTMENT

Statesville Office (704) 878-5305 Mooresville Office (704) 660-3625 PERMIT # 214721

IMPROVEMENT PERMIT / AUTHORIZATION TO CONSTRUCT / OPERATION PERMIT / EXISTING SYSTEM

PIN # 4703189562

APPLICANT: Pamela Brawley APPLICANT ADDRESS: 297 Mock Mill Rd.

SITE ADDRESS: 297 Mock Mill Rd. PHONE: 704-872-4934 ALT. PHONE: N/A

SITE DIRECTIONS: I-40 W to Old Mtn Rd TL Old Mtn Rd TR Beulah Rd Straight to Mock Mill Rd.

SUBDIVISION: N/A SECTION: N/A LOT # N/A LOT AREA: 6.11 acres DESIGN FLOW: Existing L.T.A.R.: Existing

Septic Tank	1000 (gal)	STB	1000-160	Date	9-7-15		
Pump Tank	(gal)	PT		Date			
Pump Make		Model		Serial #			
# Nitrification Fields	Ex	# Lines	Ex	Linear Ft:	Ex		
Trench Width	Ex	Max. Trench Bottom Depth	Ex	Gravel Depth	Ex		

☐ New System ☑ Repair ☐ Expansion System Type: I (II) III IV V VI

System Description:

Repair System Description: TANK

Maintenance Agreement Required: ☐ YES ☑ NO

☑ GRAVITY ☐ PRESSURE

☑ Residence No. Bedrooms Ex

☐ Business No. Persons Ex

☐ Other No. Employees


☐ Slab ☐ Crawl Space

☑ Basement w/plumbing ☐ Basement w/o plumbing


Water Supply: ☑ Private ☐ Public ☐ Community

Comments / Conditions: Pump & crush existing Septic tank, Set new tank @ location shown below & connect to existing Drainfield.

INITIAL SITE SKETCH

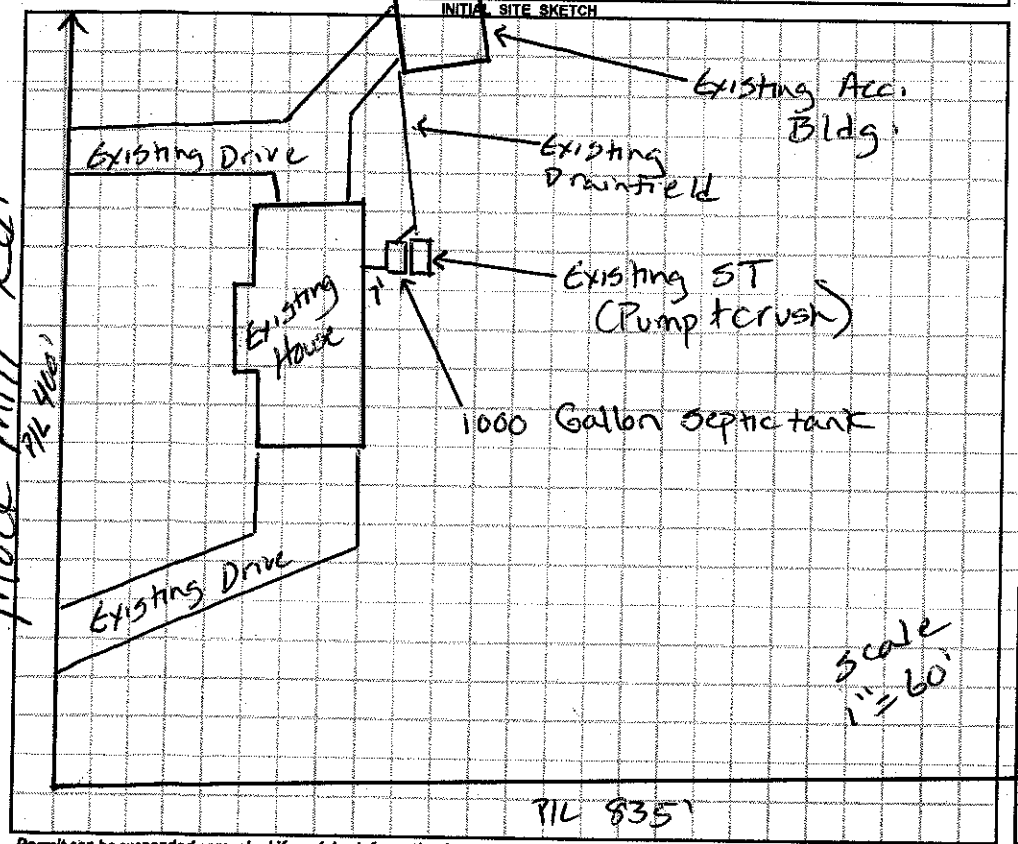

AS BUILT SKETCH

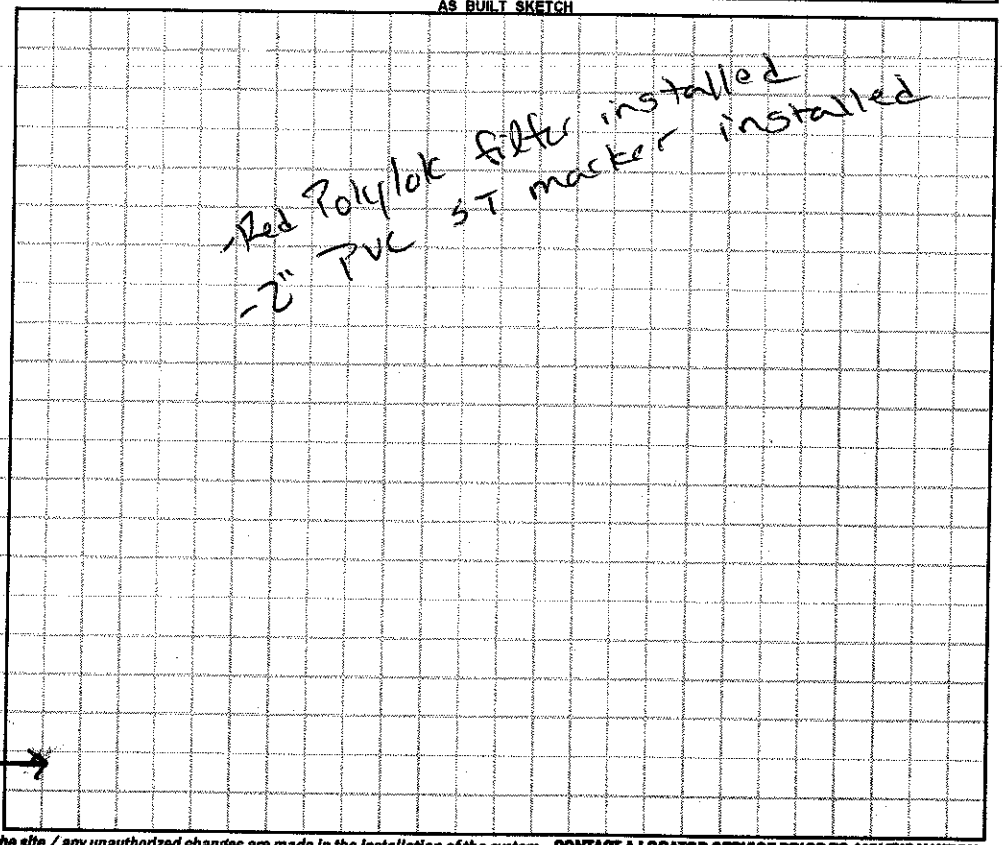

Permit can be suspended or revoked if any false information is supplied toward securing the permit / any unauthorized changes are made to the site / any unauthorized changes are made in the installation of the system. **CONTACT A LOCATOR SERVICE PRIOR TO ANY EXCAVATION**

☐ **IMPROVEMENT PERMIT** *with plat valid without expiration.* ☑ **IMPROVEMENT PERMIT** *with site plan valid for 60 mos.* ☑ **AUTHORIZATION TO CONSTRUCT** *valid for period equal to IMPROVEMENT PERMIT--not to exceed 60 mo.*

Owner / Applicant Signature: Pamela Brawley Date:

Installed by: K & M Grading

IMPROVEMENT PERMIT by: Justin Henderson Date: 11-13-15

OPERATION PERMIT by: Justin Henderson Date: 11-18-15

AUTHORIZATION TO CONSTRUCT by: Justin Henderson Date: 11-13-15

Existing System Inspected by: Date:

Health Dept. Copy - WHITE Applicant (Final Approval) - YELLOW Applicant (Conditional Approval) - PINK