IREDELL COUNTY HEALTH DEPARTMENT

Statesville Phone TR 3-7271 — Mooresville Phone NO 3-1271

PERMIT TO INSTALL SEPTIC TANK

Permit No. 5 — Permit Date 7-21 1972

Owner Early Hager, Bldr. - Carl Starnes owner — Address Statesville N.C.

Installed By Harlee Lackey — Address Stony Point N.C.


Location of Property Out Hwy 64 - Just before Tom Wilson Gro T.L. on Dirt Rd #1371 - go about 100 yards and T.R. in Drive - House in Woods off of Road

Tank		Capacity		Length of Lines		Fixtures	
Block	( )	1000	( )	225'	( )	No. of Baths	(2)
Precast	(✓)	1250	(✓)	250'	( )	Dishwasher	(✓)
		1500	( )	Other 255		Garbage Grdr.	(✓)
		Other				Other	

NOTIFY HEALTH DEPARTMENT AT LEAST EIGHT HOURS BEFORE TANK IS TO BE INSPECTED.

Final Inspection 7-21 1972 — Approved (✓) Disapproved ( )

Remarks Water from Spring ?

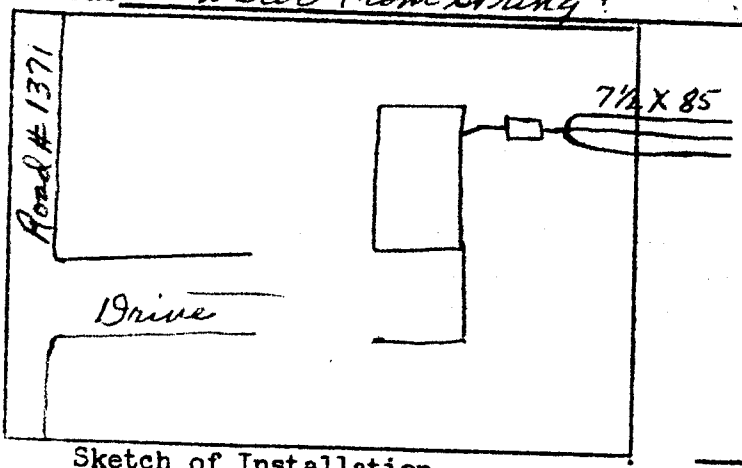

Sketch of Installation

E. A. Stevenson

Sanitarian