IREDELL COUNTY HEALTH DEPARTMENT

Statesville Phone TR 3-7271 Mooresville Phone NO 3-1271

PERMIT TO INSTALL SEPTIC TANK

Permit NO. _____ Permit Date Oct 6 1960

Owner TOM WILSON Address RT 4 3

Installed By OSTWALT Address TROUTMAN


Location of Property 2P HICKORY Hwy (#70) TEXACO SER STA. ON LEFT - HOUSE JUST BESIDE

Tank		Capacity		Length of Lines		Fixtures	
Block	(✓)	800	( )	150'	( )	No. of Baths	(1)
Precast	( )	900	( )	175'	( )	Dishwasher	( )
		1000	(✓)	200'	( )	Garbage Grdr.	( )
		1100	( )	225'	(✓)	Auto-Washer	( )
		1200	( )	250'	( )	Other	
		Other		Other			

NOTIFY HEALTH DEPARTMENT AT LEAST EIGHT HOURS BEFORE TANK IS TO BE INSPECTED.

Final Inspection Oct 6 1960 Approved (✓) Disapproved ( )

Remarks EXCELLENT JOB - SOIL HARD & IMPERVIOUS

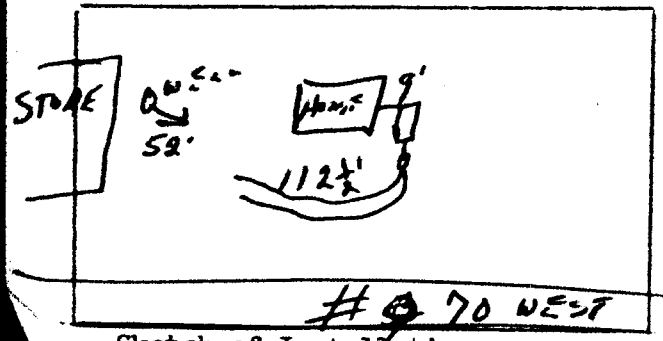

Sketch of Installation

Rafael A. Thomas

Sanitarian