IREDELL COUNTY HEALTH DEPARTMENT

Statesville Phone TR 3-7271 Mooresville Phone NO 3-1271

PERMIT TO INSTALL SEPTIC TANK

Permit NO._____ Permit Date June 1 1960

Owner Tom Wilson Address RFD Statesvillen N. C.

Installed By Smith Setzer Address _____


Location of Property Up #70 west large supper market about 8 miles out Texico

Tank		Capacity		Length of Lines		Fixtures	
Block	( )	800	( )	150'	( )	No. of Baths	(2)
Precast	(X)	900	(X)	175'	( )	Dishwasher	( )
		1000	( )	200'	( )	Garbage Grdr.	( )
		1100	( )	225'	(X)	Auto-Washer	( )
		1200	( )	250'	( )	Other	_____
		Other	_____	Other	_____		

NOTIFY HEALTH DEPARTMENT AT LEAST EIGHT HOURS BEFORE TANK IS TO BE INSPECTED.

Final Inspection June 1 19 60 Approved (X) Disapproved ( )

Remarks Water from drains building & washer should be run around notification lines

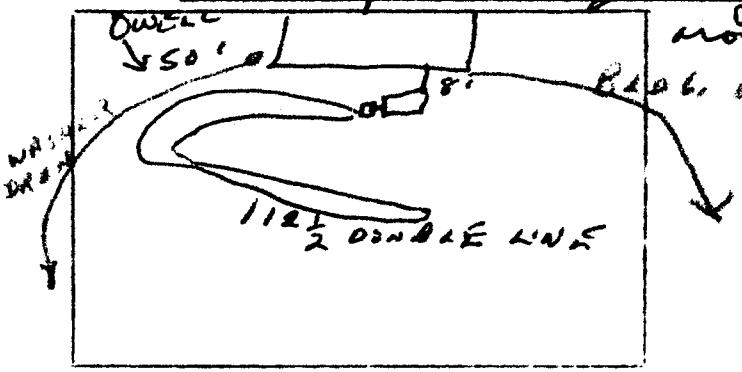

Sketch of Installation

Roland A. Thomas

Sanitarian