IREDELL COUNTY HEALTH DEPARTMENT - *ENVIRONMENTAL HEALTH* ☐ STATESVILLE OFFICE 704-878-5305 ☐ MOORESVILLE OFFICE 704-664-5281

IMPROVEMENT PERMIT / AUTHORIZATION TO CONSTRUCT / OPERATION PERMIT / EXISTING SYSTEM INSPECTION

PERMIT # REPAIR PIN # 4703-23-5937 DATE JANUARY 31, 2011

OWNER RONNIE THOMPSON APPLICANT: PHONE: Home/Cell # 704-902-1852 Business # 704-902-9851

SITE ADDRESS 3545 HICKORY HIGHWAY OWNER / APPLICANT ADDRESS

SITE DIRECTIONS US 70 WEST ON LEFT ACROSS FROM BENFIELD ROAD AT # 3545

SUBDIVISION BLOCK / SECTION LOT # LOT AREA 3.1 ACRES DESIGN FLOW 360 L.T.A.R. EXISTING

Septic Tank 1000 Gallons: STB 1012 Date 1-12-09 ☐ New System ☑ Repair ☐ Expansion System Type I (II) III IV V VI

Pump Tank Gallons: P T Date System Description:

Pump Make Model Serial # Repair System Description: CONVENTIONAL, GRAVITY

No. Nitrification Fields: EX No. Lines EX Linear Feet EX Maintenance Agreement Required ☐ YES ☐ NO

Trench Width EX Max. Trench Bottom Depth EX Gravel Depth EX ☑ GRAVITY ☐ PRESSURE

☑ Residence No. Bedrooms 3 ☐ Business No. Persons ☐ Other No. Employees ☐ Slab ☐ Crawl Space ☐ Basement w/plumbing ☐ Basement w/o plumbing


Water Supply: ☑ Private ☐ Public ☐ Community

Comments / Conditions REPLACE SEPTIC TANK AS SHOWN. MINIMUM 5' FROM FOUNDATION, 5' FROM PROPERTY LINE


P.L. 13' PROPERTY LINE 233'

SEPTIC TANK WITH MARKER INSTALLED USING REG "POLYLOK" FILTER

INITIAL SITE SKETCH

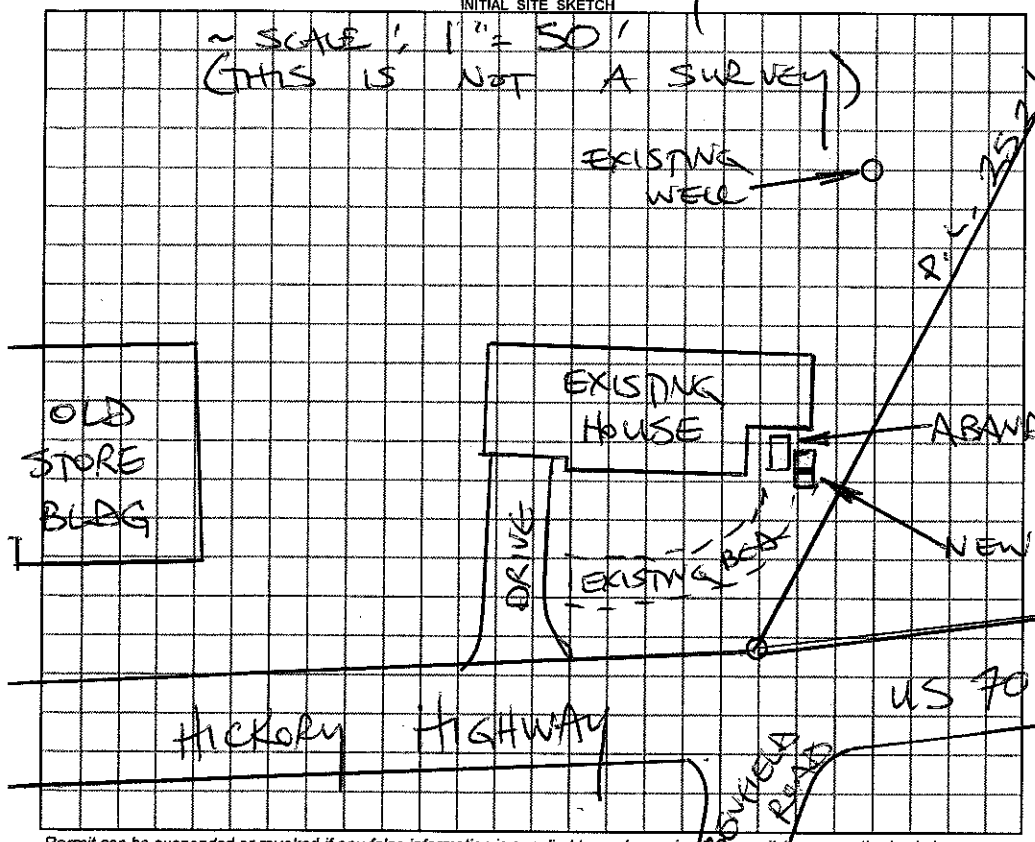

AS BUILT SKETCH

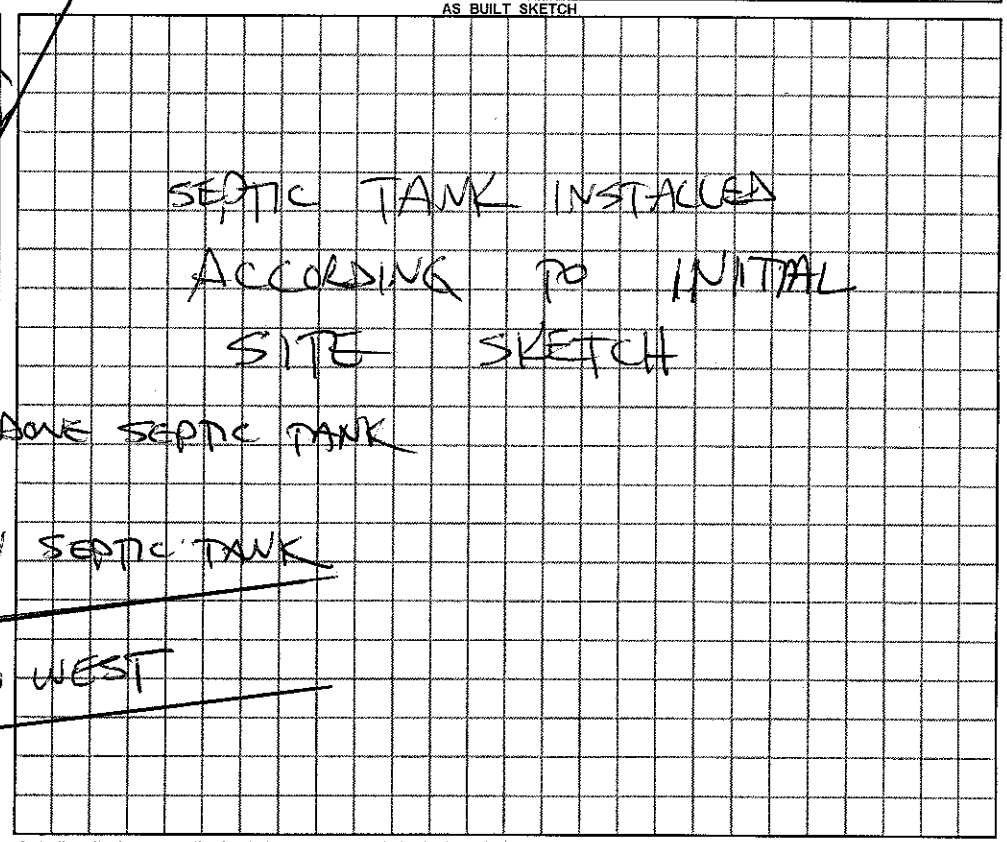

Permit can be suspended or revoked if any false information is supplied toward securing the permit / any unauthorized changes are made to the site / any unauthorized changes are made in the installation of the system.

☐ ***IMPROVEMENT PERMIT*** with plat valid without expiration. ☐ ***IMPROVEMENT PERMIT*** with plat valid ~~without expiration~~ 60 mos ☐ ***AUTHORIZATION TO CONSTRUCT*** valid for period equal to IMPROVEMENT PERMIT--not to exceed 60 mo.

Owner / Applicant Signature: Ronnie Thompson Date 2-1-11 Installed by: DAVID YOUNTZ

IMPROVEMENT PERMIT by: STEVE HEDRICK REHS Date 1-31-2011 OPERATION PERMIT by: STEVE HEDRICK REHS Date 2-9-11

AUTHORIZATION TO CONSTRUCT by: STEVE HEDRICK REHS Date 1-31-2011 Existing System Inspected by: REHS Date

YOU SHOULD CONTACT A LOCATOR SERVICE PRIOR TO ANY EXCAVATION

White Copy – Environmental Health YELLOW COPY (Final) Owner / Applicant PINK COPY (Initial) Owner / Applicant