IREDELL COUNTY HEALTH DEPARTMENT

Statesville Phone TR 3-7271 Mooresville Phone NO 3-1271

PERMIT TO INSTALL SEPTIC TANK

Permit NO. _____ Permit Date AUG 16, 1961

Owner TOM WILSON Address RT # 8 SIA

Installed By SETZER Address CATAWBA

Location of Property NO OLD #70 SUPER MKT BEFORE MORGANS MITE


Tank		Capacity		Length of Lines		Fixtures	
Block	( )	800	( )	150'	( )	No. of Baths	( )
Precast	( )	900	( )	175'	( )	Dishwasher	( )
		1000	( )	200'	( )	Garbage Grdr.	( )
		1100	( )	225'	( )	Auto-Washer	( )
		1200	( )	250'	( )	Other	
		Other		Other			

REPAIR

NOTIFY HEALTH DEPARTMENT AT LEAST EIGHT HOURS BEFORE TANK IS TO BE INSPECTED.

Final Inspection AUG 16, 1961 Approved (✓) Disapproved ( )

Remarks _____

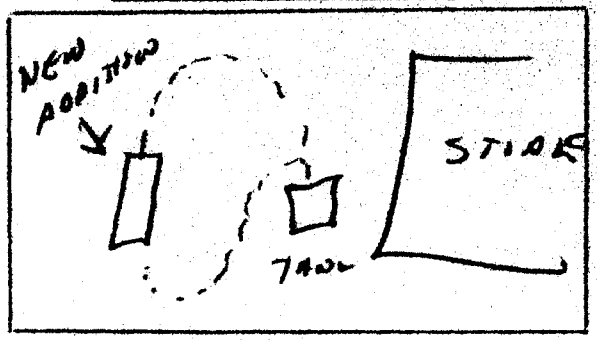

Sketch of Installation

Raford G. Thomas

Sanitarian