IREDELL COUNTY HEALTH DEPARTMENT

(SEPTIC TANK) IMPROVEMENTS PERMIT AND CERTIFICATE OF COMPLETION
(Ground Absorption Sewage Disposal System G. S. Chapter 130-Article 13C)

OWNER OR CONTRACTOR Glenn Gibson DATE 3-20-74 PERMIT NO. _____

PHONE: Business _____ Home _____

LOCATION Hwy 64-70 W. Tk. on Rd 1371 Near Tom Wilson Store. T.R. 2nd Driveway. Trailer back off Rd in Woods S. R. No. _____

SUBDIVISION NAME _____ LOT NO. _____ SECTION OR BLOCK NO. _____


House ( ) Mobile Home (✓) Business ( ) Other _____

No. Bedrooms _____ No. Bathrooms _____

Garbage Disposal Unit	Yes ( )	No ( )	
Auto. Dishwasher	Yes ( )	No ( )	
Auto. Wash. Machine	Yes ( )	No ( )	
Site Suitable	Yes ( )	No ( )	

Lot Area 2 Acres

Character & Porosity of Soil _____
Percolation Rate _____
Topography _____
Depth to Water Table _____
Rock or other impervious formations _____

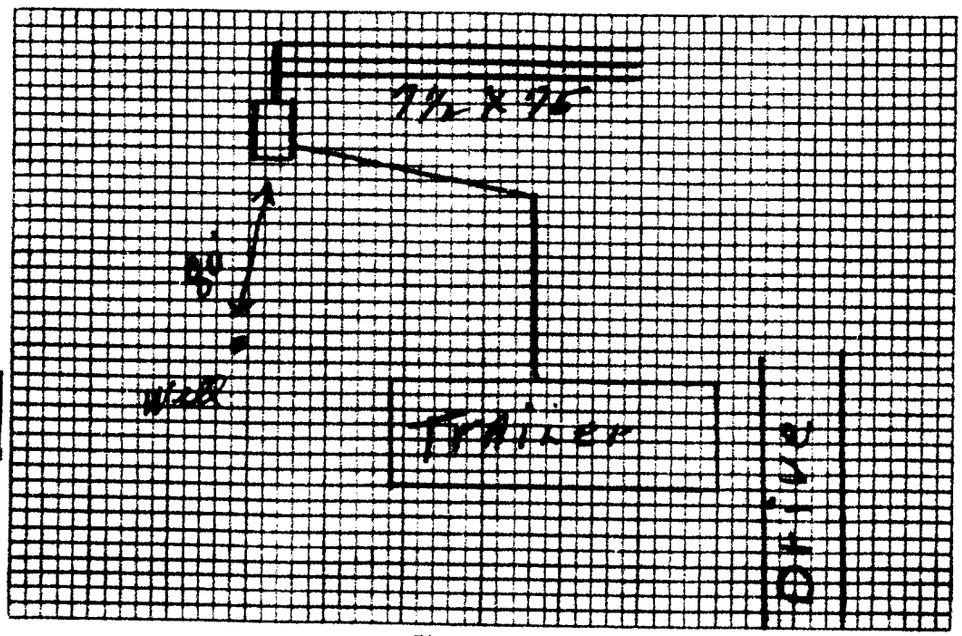

Plot of System

Size of Tank 1000 Gals.
Nitrification Field:
No. of Lines 3
Sq. Ft. 562½ Linear Ft. 225
Depth of Stone in Lines 10"
Water Supply: Individual (✓)
Public ( )

Installed by Lackey Bro
This System was installed on 5/14/73

IMPROVEMENTS PERMIT BY _____

COMMENTS: This is an existing system. No signs of any Problems.
Property formerly owned by Jerry Wright.

CERTIFICATE OF COMPLETION BY E. A. Stevenson DATE 3-20-74

CONSTRUCTION MUST COMPLY WITH ALL OTHER APPLICABLE STATE AND LOCAL REGULATIONS.

Health Dept. Copy: White Inspection Dept. Copy: Yellow Sanitarian's Copy: Pink Owner's Copy: Gold