IREDELL COUNTY HEALTH DEPARTMENT

Statesville Phone TR 3-7271 Mooresville Phone No. 664-52

PERMIT TO INSTALL SEPTIC TANK

Permit No. _____ Permit Date 5-14 1973

Owner Jerry Wright Address Statesville NC

Installed By Lackey Bro Address Stony Point NC.


Location of Property Out Hickory Hwy to Tom Wilsons Store T.L. on Rd 1321 - T.R. 2nd dirt driveway Trailer back off road in Woods.

Tank		Capacity		Length of Lines		Fixtures	
Block	( )	1000	(✓)	225'	(✓)	No. of Baths	( )
Precast	(✓)	1250	( )	250'	( )	Dishwasher	( )
		1500	( )	Other _____		Garbage Grdr.	( )
		Other _____				Other _____	

NOTIFY HEALTH DEPARTMENT AT LEAST EIGHT HOURS BEFORE TANK IS TO BE INSPECTED.

Final Inspection 5-14 1973 Approved (✓) Disapproved ( )

Remarks Well 80' away

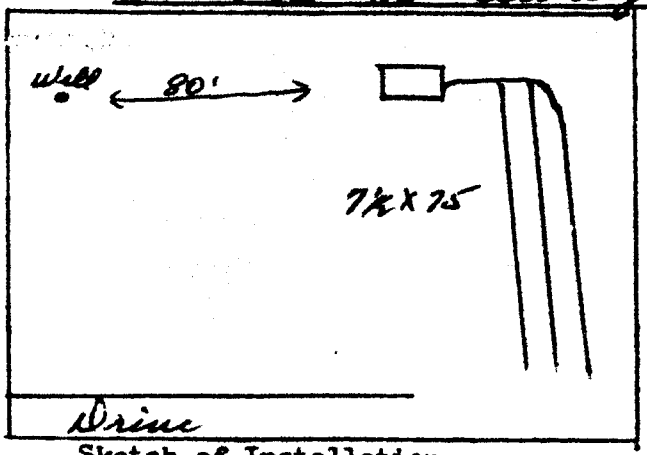

Sketch of Installation

Trailer not on lot at time of inspection. This installation for 1 trailer only.

E. A. Stevenson

Sanitarian