IREDELL COUNTY HEALTH DEPARTMENT

STATESVILLE 704-878-5305 MOORESVILLE 704-664-5281

IMPROVEMENT PERMIT / CERTIFICATE OF COMPLETION / OPERATION PERMIT / EXISTING SYSTEM INSPECTION

PROPERTY DESCRIPTION NO. Repair DATE 3-10-94 TAX MAP NO. Repair Watershed: ☐ Yes ☑ No

OWNER OR CONTRACTOR Bobby Bearer PHONE: Business _____ Home 872-1045

ADDRESS Rt. 3 Box 301 Statesville N.C. 28677

LOCATION I-40 W TL Old Mtn. Rd. TR Hwy 70 TR Benfield Rd. House approx. 3/4 mile on R (Brick house with yellow Trim)

SUBDIVISION NA BLOCK / SECTION NA LOT NA LOT AREA 3.0 acre SITE CLASS. Repair DESIGN FLOW 360 L.T.A.R. Repair

Septic Tank: Existing Gallons; STB — Date —
Pump Tank: — Gallons; PT — Date —
Pump Make: — Model — Serial No. —
Nitrification Field: No Fields 2 Square Feet 900 Linear Feet 300'
No Lines 2 Trench Width 36" Max Trench Bottom Depth 24" Gravel Depth 12"

☐ New System ☑ Repair System Type: I, II, III, IV, V, VI
System Description: Conventional, gravity fed
Repair System Description: _____
Maintenance Agreement Required: ☐ Yes ☐ No

☑ House/Mod. Home No. Bedrooms 3
☐ Mobile Home No. Bathrooms 1.5
☐ Business No. Employees _____
☐ Other _____
☐ Slab ☐ Crawl Space ☐ Basement w/plumbing ☑ Basement wo/plumbing


Water Supply: ☑ Individual ☐ Community ☐ Public

Comments: INSTALL SYSTEM SHALLOW (no deeper than 24" to trench bottom) Keep Nitrification Lines and Trenches on contour. Keep supply line min. 25' from well. Keep drain lines min. 50' from well. Keep system 10' from all property lines, 10' from Interceptor drain, and 6' from existing system.

Comments: Checked Lines 7-7-94. used tee instead of ball-run-valve due to old drain lines being clogged up. Interceptor drain checked 8-29-94. The first 30' did not have fall. If this caused problem, interceptor drain will have to be drained from both ends. This was O.K'ed by owner and contractor.

C.O.C not issued on 8-29-94 due to interceptor drain not running to day light. Checked it on 1-25-95

INITIAL SITE SKETCH

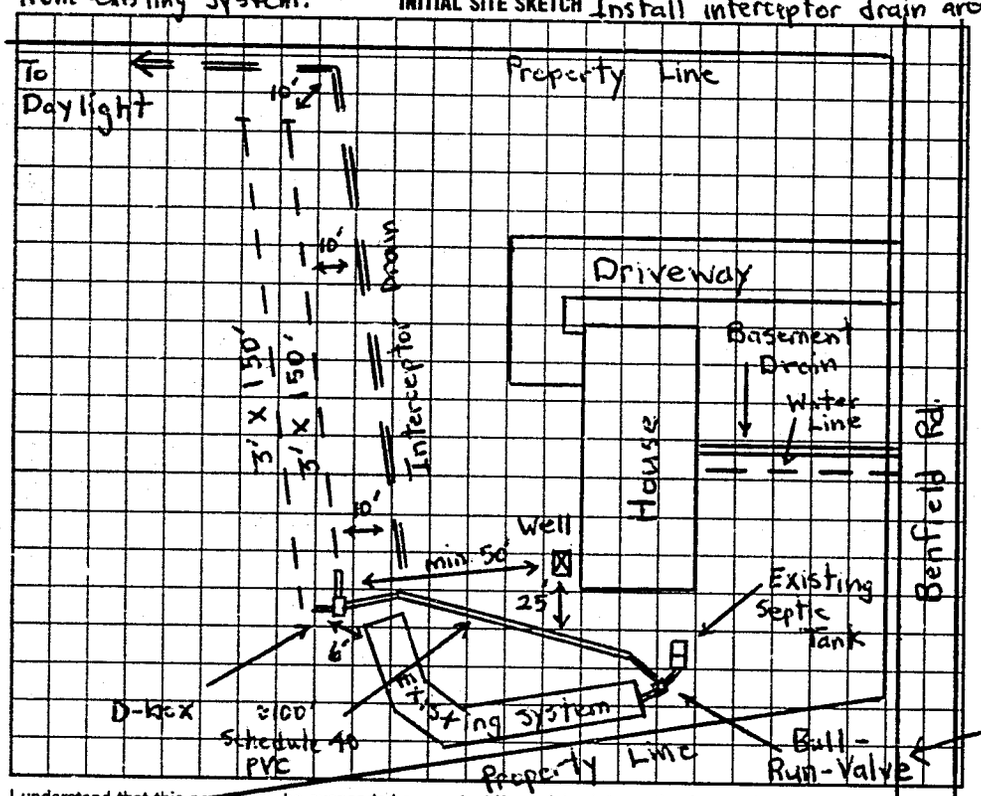

Install interceptor drain around septic system. Keep it min. 3' deep, 6" wide and fill with gravel up to 6" to surface. Run to daylight. From septic tank install Bull-Run-Valve between existing system and Repair. Call Health Dept. for inspection before adding gravel to interceptor drain. Install washing machine line into septic tank.

AS BUILT SKETCH

SAME AS INITIAL SKETCH.

used tee instead of Bull-Run-valve.

I understand that this permit can be suspended or revoked if any false information is supplied toward securing the permit/any unauthorized changes are made to the site/any unauthorized changes are made in the installation of the system. Improvement Permit is valid for 60 months from date of issuance.

Signed: Bobby L Bearer

Improvement Permit by: Michael J. Dennis/J.C. Moore date 3-10-94

Existing System Inspection by: _____ date _____

Installed by: A-1 Backhoe

Certificate of Completion by: Michael J Dennis date 1-25-95

Operation Permit by: _____ date _____

HEALTH DEPT COPY: WHITE INSPECTION COPY (FINAL) GREEN OWNER COPY (FINAL): YELLOW INSPECTION COPY (INITIAL) PINK OWNER COPY (INITIAL): GOLD

0 8 6 2 0 0