IREDELL COUNTY HEALTH DEPARTMENT

Statesville Phone TR 3-7271 Mooresville Phone NO 3-1271

PERMIT TO INSTALL SEPTIC TANK

Permit No. Buffkin Lumber Co. Permit Date Oct 22 1965

Owner Providence Ch. of Living Gsd. Address R 8

Installed By C. Hoke & Sons - Address R7


Location of Property Hwy 6420 across from Tom Wilson Texaco!

Tank		Capacity		Length of Lines		Fixtures	
Block	( )	1000	(✓)	225'	(✓)	No. of Baths	( )
Precast	(✓)	1250	( )	250'	( )	Dishwasher	( )
		1500	( )	Other		Garbage Grdr.	( )
		Other				Other 2 stoves	

NOTIFY HEALTH DEPARTMENT AT LEAST EIGHT HOURS BEFORE TANK IS TO BE INSPECTED.

Final Inspection 19 Approved ( ) Disapproved ( )

Remarks Worked with 50'

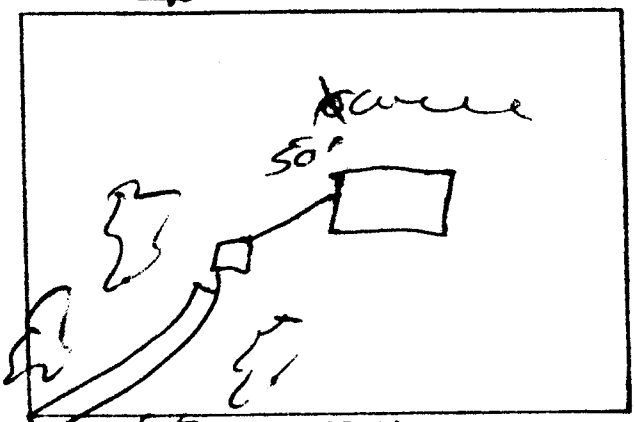

Sketch of Installation

Not Check

TE Hoke Sanitarian