IREDELL COUNTY HEALTH DEPARTMENT

STATESVILLE 704-878-5305 MOORESVILLE 704-664-5281

IMPROVEMENT PERMIT / AUTHORIZATION TO CONSTRUCT / OPERATION PERMIT / EXISTING SYSTEM INSPECTION

PERMIT# Repair PIN# — DATE 4/15/02

OWNER OR CONTRACTOR Randy Hartness PHONE: Business — Home (704) 873-13769

ADDRESS 133 Pagenhart Farm Rd Statesville N.C 28677

LOCATION US 70 W, past Three oaks, (R) Pagenhart Farm Rd. 4th on Left

SUBDIVISION — BLOCK / SECTION — LOT — LOT AREA — SITE CLASS 5 DESIGN FLOW 360 L.T.A.R. .30

Septic Tank: Existing Gallons: STB — Date —
Pump Tank: — Gallons: PT — Date —
Pump Make: — Model — Serial No. —
Nitrification Field: No Fields 1 Square Feet 990 Linear Feet 220
No Lines 4 Trench Width 36" Max Trench Bottom Depth 32" Gravel Depth 19"

☐ New System ☒ Repair System Type: ☒ I ☐ II ☐ III ☐ IV ☐ V ☐ VI
System Description: —
Repair System Description: Gravity Conventional
Maintenance Agreement Required: ☐ Yes ☒ No
☐ Slab ☒ Crawl Space ☐ Basement w/plumbing ☐ Basement wo/plumbing


☒ House/Mod. Home No. Bedrooms 3
☐ Mobile Home No. Bathrooms 1
☐ Business No. Employees —
☐ Other —

Water Supply: ☐ Individual ☒ Public ☐ Community

Comments/Conditions: ① Install Liner on contour ② Maintain proper Setbacks 5' from PL ③ Pump Tank before sys. repair ④ Install new Septic Tank if needed ⑤ Abandon 2d Septic Area ⑥ This permit serves as Notice of Violation you have 30 days from 4/15/02

Comments/Conditions:

INITIAL SITE SKETCH

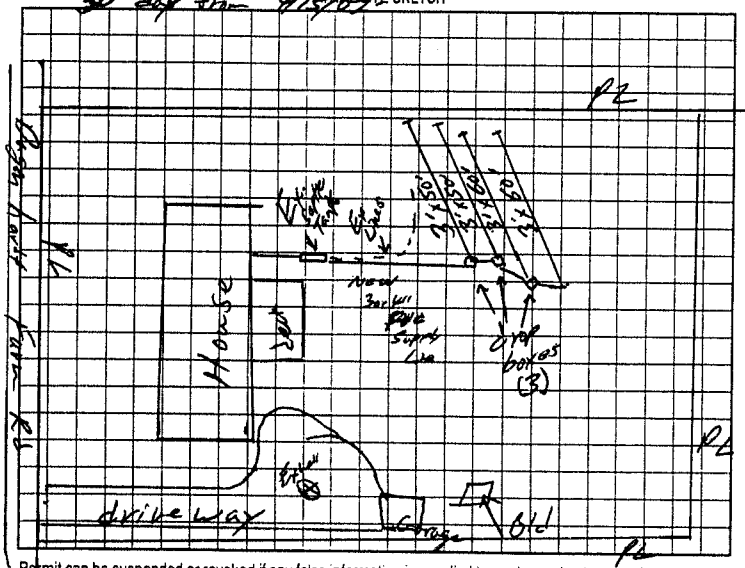

AS BUILT SKETCH

SYSTEM REPAIRED ACCORDING TO INITAL SITE SKETCH

Permit can be suspended or revoked if any false information is supplied toward securing the permit/any unauthorized changes are made to the site any unauthorized changes are made in the installation of the system. Improvement Permit with plat valid without expiration. Improvement Permit with site plan valid for sixty months Authorization to Construct is valid for a period equal to that of Improvement Permit – not to exceed sixty months

Signed: Randy J Hartness date 4-15-02 installed by: ESKER ELDER

Improvement Permit by: William A. Johnson date 4/15/02 Operation Permit by: STEVE HEDRICK date 4-22-02

Authorization to Construct by: William A. Johnson date 4/15/02 Existing System Inspection by: — date —

HEALTH DEPT COPY: WHITE OWNER COPY (FINAL): YELLOW OWNER COPY (INITIAL): PINK