IREDELL COUNTY HEALTH DEPARTMENT

Statesville Phone TR 3-7271 Mooresville Phone NO 3-1271

PERMIT TO INSTALL SEPTIC TANK

Permit NO. _____ Permit Date October 26 1959

Owner Ralph Jay Builder Address _____

Installed By CLYDE HOKE Address _____
Rt. 7 Box 312


Location of Property N. C. Rt on dirt before Tom Wilson
3-574
terrace Sta. on Hickory Rd. 6th on left new brick

Tank:		Capacity		Length of Lines		Fixtures	
Block	( )	800	( )	150'	( )	No. of Baths	(1½)
Precast	(✓)	900	(✓)	175'	( )	Dishwasher	( )
		1000	( )	200'	( )	Garbage Grdr.	( )
		1100	( )	225'	( )	Auto-Washer	(✓)
		1200	( )	250'	( )	Other	_____
		Other	_____	Other	240'		

NOTIFY HEALTH DEPARTMENT AT LEAST EIGHT HOURS BEFORE TANK IS TO BE INSPECTED.

Final Inspection _____ 195__ Approved ( ) Disapproved ( )

Remarks Septic - Well 50'

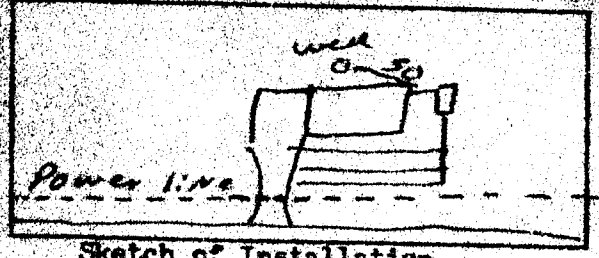

Sketch of Installation

Rut,

Sanitarian