IREDELL COUNTY HEALTH DEPARTMENT

STATESVILLE 704-878-5305 CI MOORESVILLE 704-664-5281

IMPROVEMENT PERMIT / AUTHORIZATION TO CONSTRUCT / OPERATION PERMIT / EXISTING SYSTEM INSPECTION

PERMIT# 102791 PIN# ~~4703-26-6903~~ ~~4703-26-6630~~ 4703-26-6811 DATE 7/18/02

OWNER OR CONTRACTOR ~~Rick Horsham~~ Carolyn Sanderson PHONE: Business (704) 902-1941 Home —

ADDRESS 181 Greenwich Drive Statesville, N.C. 28677

LOCATION Hwy 70 W, (R) Shady Rest road, cross Deyenhart Farm Rd, 3rd lot on right.

SUBDIVISION — BLOCK / SECTION — LOT — LOT AREA 2.09 Ac SITE CLASS. PS DESIGN FLOW 360 L.T.A.R. ~~.825~~ gpd/Ac

Septic Tank: 1,000 Gallons; STB 1002 Date 3-14-03

Pump Tank: — Gallons; PT — Date —

Pump Make: — Model — Serial No. —

Nitrification Field: No Fields 1 Square Feet 1440 Linear Feet 360

No Lines 4@90 Trench Width 36" Max Trench Bottom Depth 36" Gravel Depth N/A

☒ New System ☐ Repair System Type: I ☐ II ☒ III IV V VI

System Description: Gravity; 25% Reduction

Repair System Description: Gravity; 25% Reduction

Maintenance Agreement Required: ☑ Yes ☒ No

☒ House/Mod. Home ☐ Mobile Home ☐ Business ☐ Other

No. Bedrooms 3 No. Bathrooms 2 No. Employees —

☐ Slab ☒ Crawl Space ☐ Basement w/plumbing ☐ Basement wo/plumbing


Water Supply: ☒ Individual ☐ Public ☐ Community

Comments/Conditions: ① Install Lines on Contour ② maintain appr. Setbacks


Comments/Conditions: -Poly lok filter Installed -S.T. marker Installed

(Not to Scale)

INITIAL SITE SKETCH

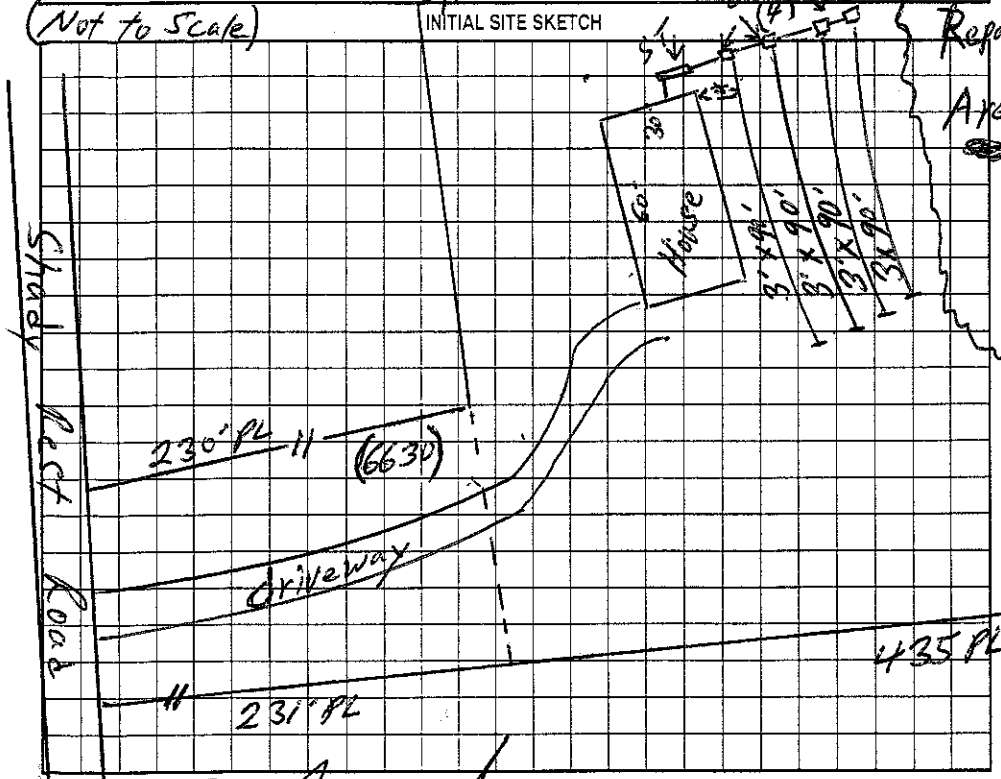

AS BUILT SKETCH

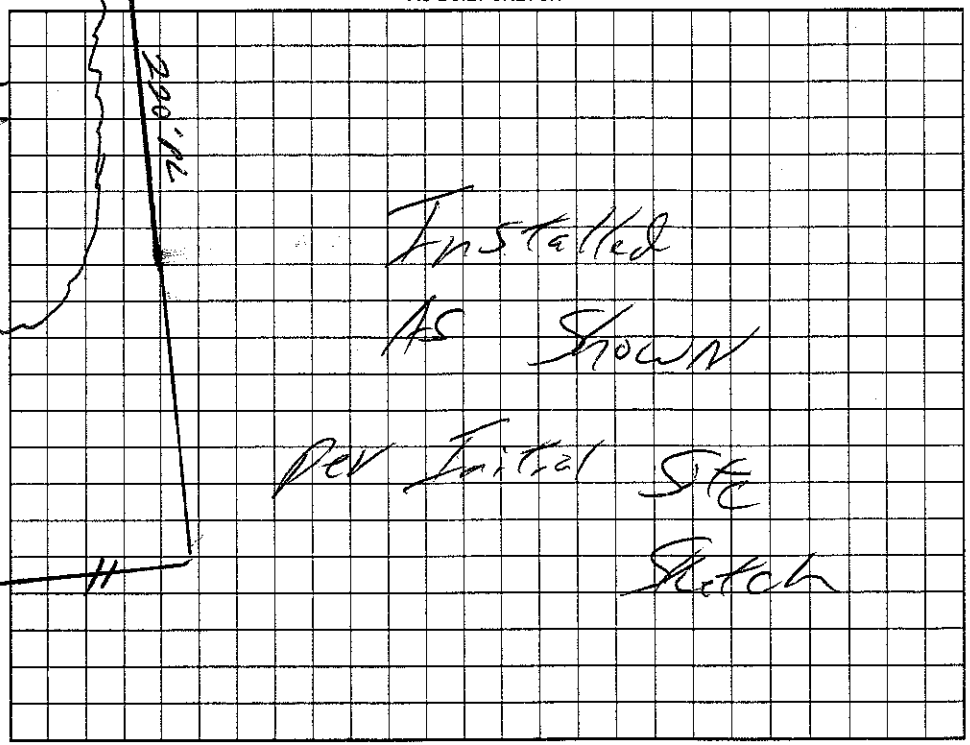

Permit can be suspended or revoked if any false information is supplied toward securing the permit/any unauthorized changes are made to the site/any unauthorized changes are made in the installation of the system. Improvement Permit with plat valid without expiration. Improvement Permit with site plan valid for sixty months. Authorization to Construct is valid for a period equal to that of Improvement Permit – not to exceed sixty months.

Signed: [signature] date —

Improvement Permit by: William O. Johnson date 7/18/02

Authorization to Construct by: William O. Johnson date 7/18/02

Installed by: Sammy Shoemaker

Operation Permit by: William O. Johnson date 8/26/02

Existing System Inspection by: — date —

HEALTH DEPT. COPY: WHITE OWNER COPY (FINAL): YELLOW OWNER COPY (INITIAL): PINK