IREDELL COUNTY HEALTH DEPARTMENT

Statesville Phone TR 3-7271 Mooresville Phone NO 3-1271

PERMIT TO INSTALL SEPTIC TANK

Permit NO. _____ Permit Date 6 - 1 - 1960

Owner Clyde Hoke Address Bradford Rd.

Installed By C. Hoke Address Rte. 7


Location of Property right at white oak. left at Brady Ch. dirt rd parell with by pass 3rd on left new brick

Tank		Capacity		Length of Lines		Fixtures	
Block	( )	800	( )	150'	( )	No. of Baths	( )
Precast	(✓)	900	(✓)	175'	( )	Dishwasher	( )
		1000	( )	200'	( )	Garbage Grdr.	( )
		1100	( )	225'	(✓)	Auto-Washer	( )
		1200	( )	250'	( )	Other	
		Other		Other			

NOTIFY HEALTH DEPARTMENT AT LEAST EIGHT HOURS BEFORE TANK IS TO BE INSPECTED.

Final Inspection 6' 60 19__ Approved ( ) Disapproved ( )

Remarks well 50'

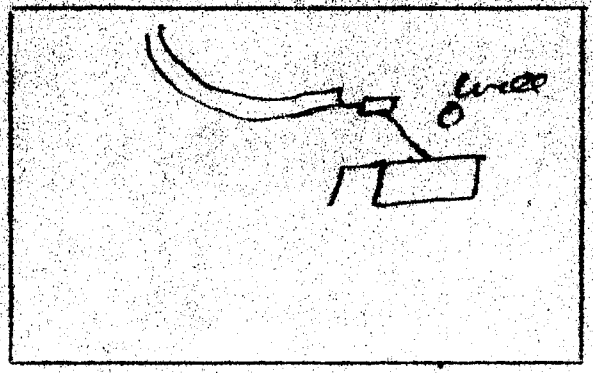

Sketch of Installation

R.L.

Sanitarian