IREDELL COUNTY HEALTH DEPARTMENT

Statesville Phone TR 3-7271 Mooresville Phone NO 3-1271

PERMIT TO INSTALL SEPTIC TANK

Permit NO. Paul Stackman Bldr. Permit Date May 1 1963

Owner Ray Pendergrass Address R 6

Installed By C Hoke Address R7

Location of Property Rat White oak Hickory Hwy - on L


100 5 - 3/4 mile left on 1510 - 1 left on 1505 - 1 left on 1508 -

Tank		Capacity		Length of Lines		Fixtures Lft Conn	
Block	( )	800	( )	150'	( )	No. of Baths	(2)
Precast	(4)	900	( )	175'	( )	Dishwasher	( )
		1000	(4)	200'	( )	Garbage Grdr.	( )
		1100	( )	225'	(4)	Auto-Washer	(4)
		1200	( )	250'	( )	Other	
		Other		Other			

NOTIFY HEALTH DEPARTMENT AT LEAST EIGHT HOURS BEFORE TANK IS TO BE INSPECTED.

Final Inspection 5-1 1963 Approved (✓) Disapproved ( )

Remarks Well 100' + 5 ft wide

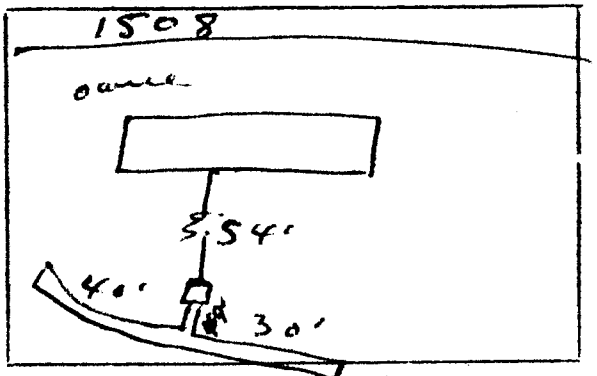

Sketch of Installation

Sanitarian