IREDELL COUNTY HEALTH DEPARTMENT

STATESVILLE 704-878-5305 MOORESVILLE 704-664-5281

IMPROVEMENT PERMIT / AUTHORIZATION TO CONSTRUCT / OPERATION PERMIT / EXISTING SYSTEM INSPECTION

PERMIT# 151830 PIN# 4703-37-4057 DATE 1 August 08

OWNER OR APPLICANT H.W. Dagenhart PHONE: Business Home 704-873-2645

ADDRESS 748 Stony Cmp Statesville, N.C.

LOCATION I-40W - TL Old NW Rd TR Mock Mill Rd TL Dagenhart Farm Rd - ½ mile on left.

SUBDIVISION BLOCK / SECTION LOT LOT AREA 1.568 ac. SITE CLASS. PS DESIGN FLOW 360 gpd L.T.A.R. 0.3 gpd/ft²

Septic Tank: 1000 Gallons: STB 1012 Date 5-6-08

Pump Tank: Gallons: PT Date

Pump Make: Model Serial No.

Nitrification Field: No Fields 1 Square Feet ≈1200 Linear Feet 300

No Lines 3 Trench Width 36" Max Trench Bottom Depth 36"

☑ New System ☐ Repair ☐ Expansion System Type: I II III IV V VI

System Description: 25% Reduction

Repair System Description: 25% Reduction

Maintenance Agreement Required: ☐ Yes ☐ No

☑ House/Mod. Home No. Bedrooms 3

☐ Mobile Home No. Persons

☐ Business No. Employees

☐ Other

Water Supply: ☑ Individual ☐ Public ☐ Community

Gravel Depth ☑ Gravity ☐ Pressure ☐ Slab ☑ Crawl Space ☐ Basement w/plumbing ☐ Basement wo/plumbing

Comments:/Conditions:

Follow contour / Honor all setback requirements.

Comments:/Conditions:

Tuff-Tite Filter

INITIAL SITE SKETCH

Please see Attached Lay-out

The location of the proposed attached 32'x34' garage addition does not appear to impact the existing septic system.


**NOTE:

REHS

Date: 10-28-10

ICHD-Environmental Health Division

AS BUILT SKETCH

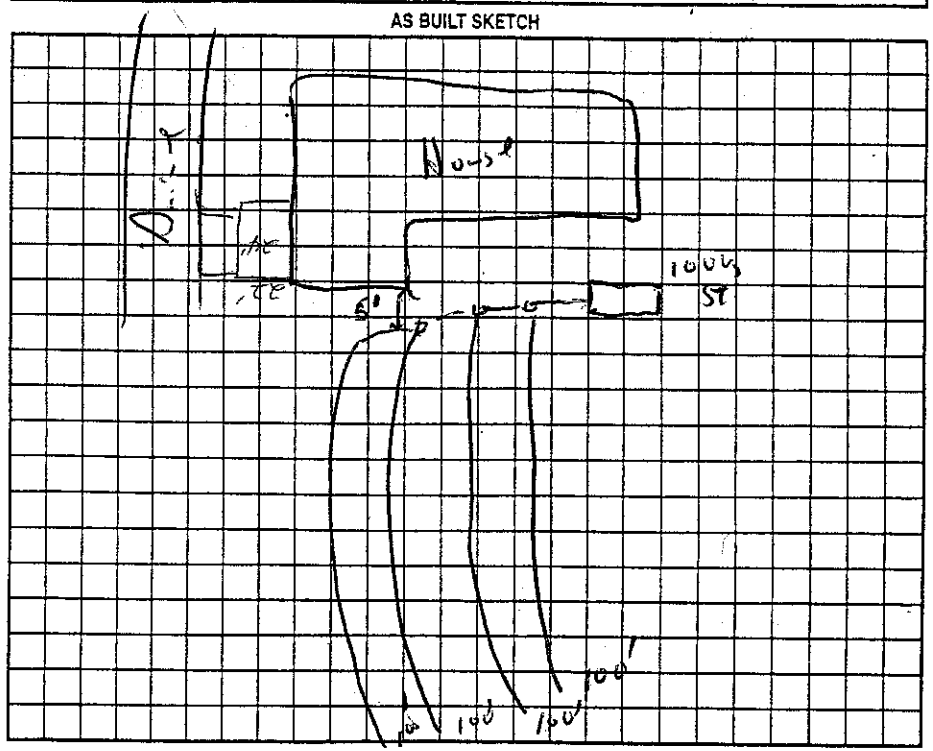

Permit can be suspended or revoked if any false information is supplied toward securing the permit/any unauthorized changes are made to the site/any unauthorized changes are made in the installation of the system. Improvement Permit with plat valid without expiration ☐ Improvement Permit with site plan valid for sixty months ☐ Authorization to Construct is valid for a period equal to that of Improvement Permit – not to exceed sixty months.

Signed: date 8-4-08

Improvement Permit by: R.S. date 1 Aug. 08

Authorization to Construct by: R.S. date 3 Sept. 08

Installed by: H. Wayne Dagenhart

Operation Permit by: R.S. date 28 Oct. 08

Existing System Inspection by: date

HEALTH DEPT. COPY: WHITE OWNER COPY (FINAL): YELLOW OWNER COPY (INITIAL): PINK