IREDELL COUNTY HEALTH DEPARTMENT

STATESVILLE 704-878-5305 MOORESVILLE 704-664-5281

IMPROVEMENT PERMIT / CERTIFICATE OF COMPLETION / OPERATION PERMIT / EXISTING SYSTEM INSPECTION

PROPERTY DESCRIPTION NO. 20501 DATE 3-14-95 TAX MAP NO. 8M-6-A-37 Watershed: ☐ Yes ☑ No

OWNER OR CONTRACTOR Jack Clanton PHONE: Business _____ Home 876-6057

ADDRESS P.O. Box 1651 Statesville, N.C. 28677

LOCATION I40W TL old Mtn Rd TR Beulah Rd Stay Straight Mock Mill Rd TL Ashley Brook Lane Lot at end on R.

SUBDIVISION Mock Mill Run BLOCK / SECTION _____ LOT 37 LOT AREA 100' x 200' SITE CLASS Existing DESIGN FLOW 360 L.T.A.R. Existing

Septic Tank: _____ Gallons; STB _____ Date _____

Pump Tank: Existing Gallons; PT _____ Date _____

Pump Make: _____ Model System Serial No. Inspection

Nitrification Field: No Fields ____ Square Feet _____ Linear Feet _____

No Lines _____ Trench Width _____ Max Trench Bottom Depth _____ Gravel Depth _____

☐ New System ☐ Repair System Type: I, II, III, IV, V, VI

System Description: Existing System

Repair System Description: Inspection

Maintenance Agreement Required: ☐ Yes ☐ No

☐ House/Mod. Home ☑ Mobile Home ☐ Business ☐ Other

No. Bedrooms 3 No. Bathrooms 2 No. Employees ____

☐ Slab ☑ Crawl Space ☐ Basement w/plumbing ☐ Basement wo/plumbing


Water Supply: ☐ Individual ☐ Community ☑ Public

Comments:

Comments: Setting 3 Bedroom MH (SW) on existing lot. Keep home min. 5' from any part of septic system. System shows no visible signs of malfunction at time of inspection. System has gone unused for an extended period of time. Recommend landscaping over system to eliminate low areas that may hold surface water.

INITIAL SITE SKETCH

AS BUILT SKETCH

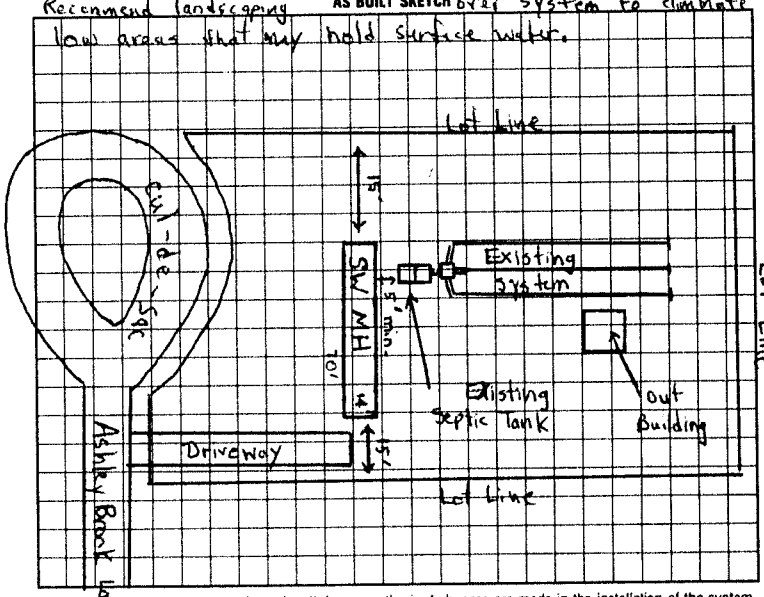

I understand that this permit can be suspended or revoked if any false information is supplied toward securing the permit/any unauthorized changes are made to the site/any unauthorized changes are made in the installation of the system. Improvement Permit is valid for 60 months from date of issuance.

Signed: _____ Installed by: _____

Improvement Permit by: _____ date _____ Certificate of Completion by: _____ date _____

Existing System Inspection by: Michael J. Dennis date 3-14-95 Operation Permit by: _____ date _____

HEALTH DEPT. COPY: WHITE INSPECTION COPY (FINAL): GREEN OWNER COPY (FINAL): YELLOW INSPECTION COPY (INITIAL): PINK OWNER COPY (INITIAL): GOLD