61569

IREDELL COUNTY HEALTH DEPARTMENT

STATESVILLE 704-878-5305 MOORESVILLE 704-664-5281

IMPROVEMENT PERMIT / CERTIFICATE OF COMPLETION / OPERATION PERMIT / EXISTING SYSTEM INSPECTION

PROPERTY DESCRIPTION NO. 24004 DATE 6-19-96 TAX MAP NO 8M-6-A-22 Watershed: Yes ✓ No

OWNER OR CONTRACTOR Melissa Brass PHONE Business Home 528-4734

ADDRESS Hol Fern Hill Rd Troutman 28166

LOCATION I-40 W TL oil mtn TR Bullock TL Mockingbird 3rd lot left (111 Mockingbird)


SUBDIVISION Mock mill Run BLOCK / SECTION LOT 22 LOT AREA 1/2 acre SITE CLASS A1 DESIGN FLOW L T A R

Septic Tank: Gallons; STB Date	New System Repair System Type I II III IV V VI	House/Mod Home No Bedrooms 3	Water Supply
Pump Tank: Gallons; PT Date	System Description	Mobile Home No Bathrooms 2	Individual
Pump Make: Model Serial No	Repair System Description	Business No Employees	Community
Nitrification Field: No Fields Square Feet Linear Feet	Maintenance Agreement Required Yes No	Other	✓ Public
No Lines Trench Width Max Trench Bottom Depth Gravel Depth	Slab ✓ Crawl Space Basement w/plumbing Basement wo/plumbing		


Comments:

Comments

INITIAL SITE SKETCH

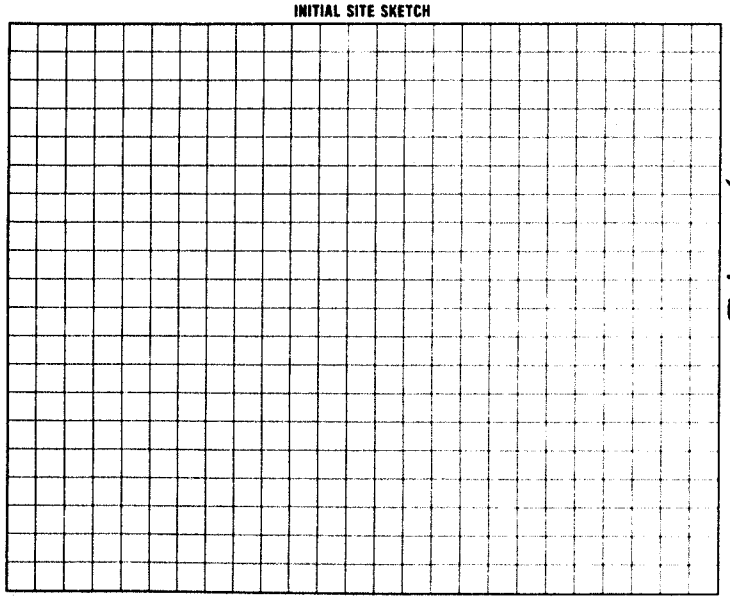

AS BUILT SKETCH

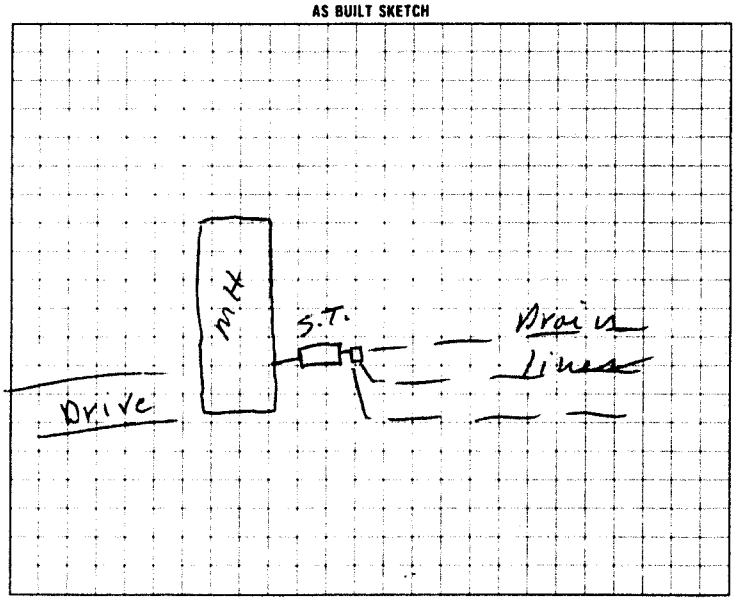

I understand that this permit can be suspended or revoked if any false information is supplied toward securing the permit, any unauthorized changes are made to the site/any unauthorized changes are made in the installation of the system

Signed

Improvement Permit by date

Existing System Inspection by L.C. Moore date 6-19-96

Installed by

Certificate of Completion by date

Operation Permit by date

HEALTH DEPT COPY WHITE INSPECTION COPY (FINAL) GREEN OWNER COPY (FINAL) YELLOW INSPECTION COPY (INITIAL) PINK OWNER COPY (INITIAL) GOLD