IREDELL COUNTY HEALTH DEPARTMENT

STATESVILLE 704-878-5305 MOORESVILLE 704-664-5281

IMPROVEMENT PERMIT / AUTHORIZATION TO CONSTRUCT / OPERATION PERMIT / EXISTING SYSTEM INSPECTION

PERMIT # 160926 PIN # 4703-43-4128 DATE 25 May 2010

OWNER or APPLICANT Joshua Archambault PHONE: Business Home: (704) 929-3639

OWNER or APPLICANT ADDRESS 225 Morrow Farm Rd. Statesville, NC.

LOCATION / DIRECTIONS Hwy 70W (Hickory Hwy) Turn Morrow Farm Rd. Prop. on Lt.

SUBDIVISION BLOCK / SECTION LOT # LOT AREA 1 AC. DESIGN FLOW 360 gpd L.T.A.R. 0.3 g/Ft.²/d

Septic Tank 1000 Gallons: STB 760 Date 12-2[illegible]

Pump Tank Gallons: P T Date

Pump Make Model Serial #

Nitrification Field No Fields 1 No Lines 3 Linear Feet 300'

Trench Width 36" Max. Trench Bottom Depth 36" Gravel Depth NA

☑ New System ☐ Repair ☐ Expansion System Type I II (III) IV V VI

System Description: 25% Reduction

Repair System Description: 25% Reduction

Maintenance Agreement Required ☐ YES ☑ NO

☑ GRAVITY ☐ PRESSURE

☑ Residence No. Bedrooms 3

☐ Business No. Persons

☐ Other No. Employees

☐ Slab ☑ Crawl Space


☐ Basement w/plumbing ☐ Basement w/o plumbing

Water Supply: ☑ Private ☐ Public ☐ Community

Comments / Conditions: Follow contour / Keep out of power Line Rt. of way.

Comments / Conditions: well located on adjacent lot.

INITIAL SITE SKETCH

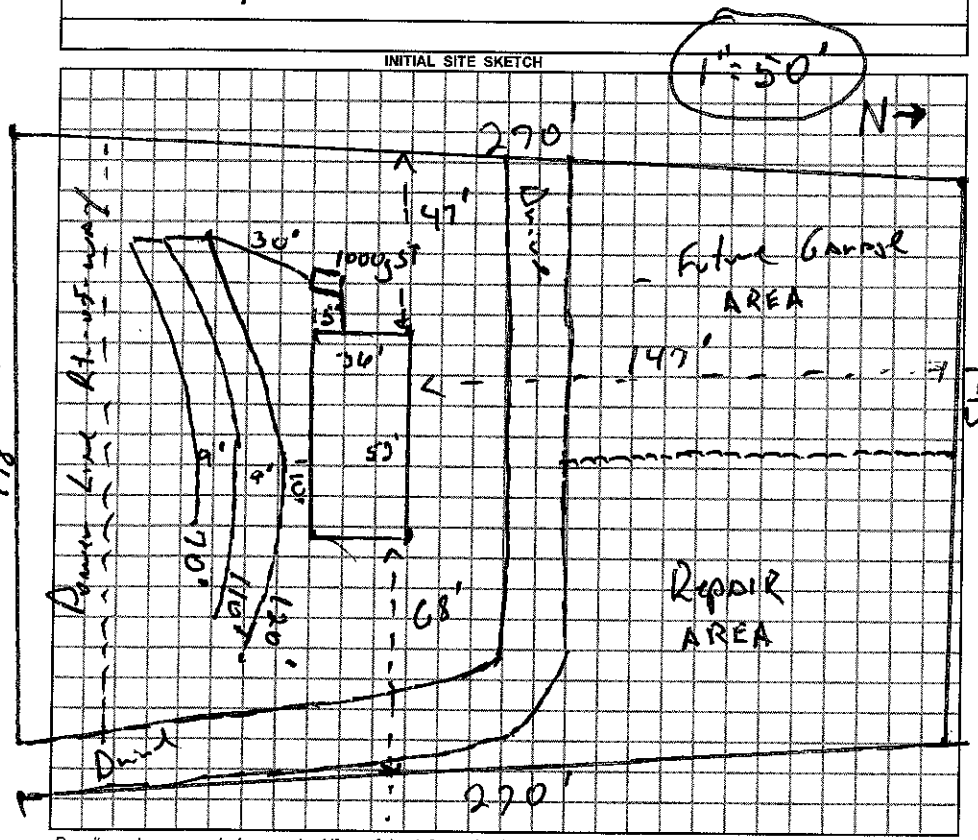

AS BUILT SKETCH

Permit can be suspended or revoked if any false information is supplied toward securing the permit / any unauthorized changes are made to the site / any unauthorized changes are made in the installation of the system.

☐ *IMPROVEMENT PERMIT w / plat valid without expiration.* ☑ *IMPROVEMENT PERMIT w / site plan valid for 60 mos.* ☑ *AUTHORIZATION TO CONSTRUCT valid for period equal to IMPROVEMENT PERMIT-not to exceed 60 mo.*

Owner / Applicant Signature: [signature] Date 5-25-10

Improvement Permit by: [signature], R.S. Date 25 May 10

Authorization to Construct by: [signature], R.S. Date 25 May 10

Installed by: A-1 Backhoe

Operation Permit by: [signature] Date: 6-14-10

Existing System Inspected by: Date:

YOU SHOULD CONTACT A LOCATOR SERVICE PRIOR TO ANY EXCAVATION.

WHITE COPY Environmental Health YELLOW COPY (Final) Owner / Applicant PINK COPY (Initial) Owner / Applicant