IREDELL COUNTY HEALTH DEPARTMENT - *ENVIRONMENTAL HEALTH* ☒ STATESVILLE OFFICE 704-878-5305 ☐ MOORESVILLE OFFICE 704-664-5281

IMPROVEMENT PERMIT / AUTHORIZATION TO CONSTRUCT @ / OPERATION PERMIT @ / EXISTING SYSTEM INSPECTION

PERMIT # 166134 PIN # 4703-46-1657 DATE 18 May 2011

OWNER Troutman Family LLC APPLICANT: Capote Bldrs. PHONE: Home/Cell # (704) 483-7313 Business #

SITE ADDRESS 127 Cub Farm Rd. Statesville OWNER / APPLICANT ADDRESS


SITE DIRECTIONS Hickory Hwy. Turn onto Shady Rest Ln. TR Cub Farm Rd.

SUBDIVISION Morrow Meadows BLOCK / SECTION LOT # 12 LOT AREA 0.454 ac. DESIGN FLOW 360 gpd L.T.A.R. 0.3 gpd/ft²

Septic Tank 1000	Gallons: STB 760	Date 3-11	☑ New System	☐ Repair	☐ Expansion System	Type I II ◉III IV V VI	☑ Residence	No. Bedrooms 3	Water Supply
Pump Tank	Gallons: P T	Date	System Description: 25% Reduction				☐ Business	No. Persons	☐ Private
Pump Make	Model	Serial #	Repair System Description: 50% Reduction LPP chamber				☐ Other	No. Employees	☑ Public
No. Nitrification Fields: 1	No. Lines 6	Linear Feet 360	Maintenance Agreement Required ☐ YES ☑ NO				☐ Slab	☑ Crawl Space	☐ Community
Trench Width 36"	Max. Trench Bottom Depth 36"		Gravel Depth NA		☑ GRAVITY	☐ PRESSURE	☐ Basement w/plumbing		☐ Basement w/o plumbing

Comments / Conditions Follow contours

INITIAL SITE SKETCH

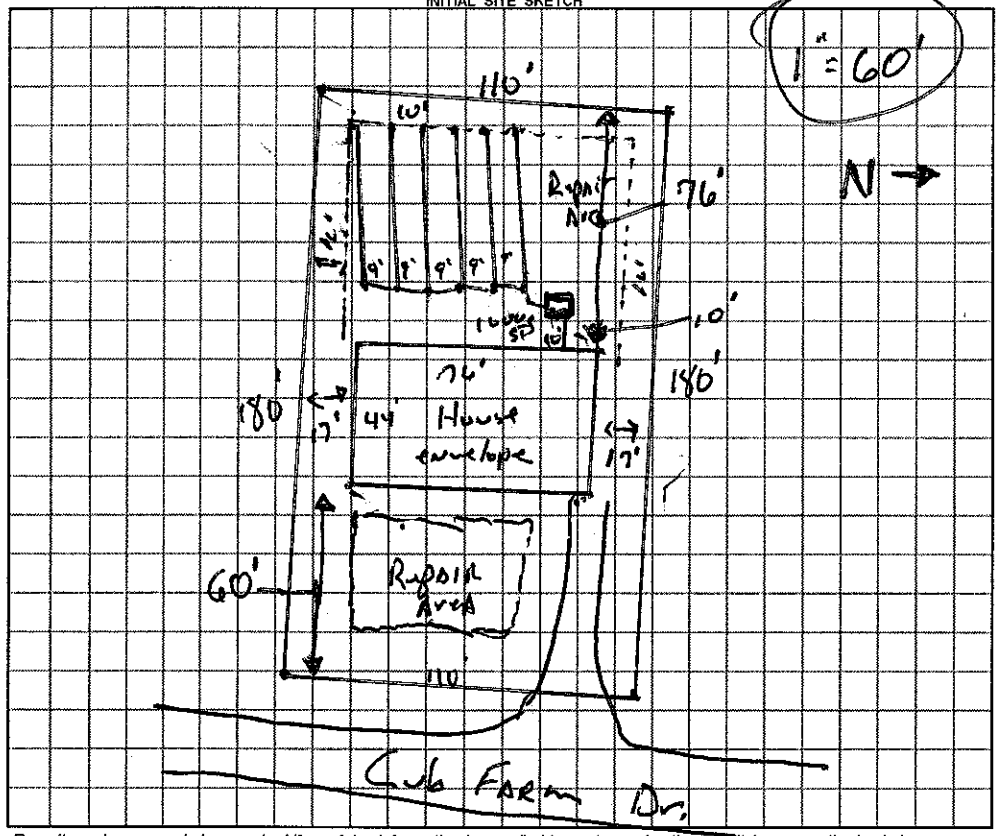

AS BUILT SKETCH

Installed As Drawn

Permit can be suspended or revoked if any false information is supplied toward securing the permit / any unauthorized changes are made to the site / any unauthorized changes are made in the installation of the system.

☐ *IMPROVEMENT PERMIT* with plat valid without expiration. ☑ *IMPROVEMENT PERMIT* with ~~plat~~ site plan valid without expiration. ☑ *AUTHORIZATION TO CONSTRUCT* valid for period equal to IMPROVEMENT PERMIT--not to exceed 60 mo.

Owner / Applicant Signature: [signature] Date 5-23-11 Installed by: Tim Abel

IMPROVEMENT PERMIT by: [signature] REHS Date 18 May 11 OPERATION PERMIT by: [signature] REHS Date 1 Jun 11

AUTHORIZATION TO CONSTRUCT by: [signature] REHS Date 18 May 11 Existing System Inspected by: REHS Date

YOU SHOULD CONTACT A LOCATOR SERVICE PRIOR TO ANY EXCAVATION

White Copy – Environmental Health YELLOW COPY (Final) Owner / Applicant PINK COPY (Initial) Owner / Applicant