# IREDELL COUNTY HEALTH DEPARTMENT

Statesville Office (704) 878-5305 Mooresville Office (704) 660-3625 PERMIT # 204421

## IMPROVEMENT PERMIT / AUTHORIZATION TO CONSTRUCT / OPERATION PERMIT / EXISTING SYSTEM

PIN # 4703479180

APPLICANT: John + Lucille Nardi APPLICANT ADDRESS: 206 English Hill Dr Mooresville NC

SITE ADDRESS: 154 Adkins Ln PHONE: 704-239-3643 ALT. PHONE: N/A

SITE DIRECTIONS: (R) on G. Baynal (L) on 70W (R) on N Shady Rest Rd (R) on Adkins Ln


SUBDIVISION: Morrow Meadows SECTION: N/A LOT # 30 LOT AREA: 1.358 ac DESIGN FLOW: 360 L.T.A.R.: 0.2

| | | | | | | | | | | | |
|---|---|---|---|---|---|---|---|---|---|---|---|
| Septic Tank | 1000 (gal) | STB | 786 | Date | 8-19-14 | [X] New System | [ ] Repair | [ ] Expansion | System Type: I II [III] IV V VI | [X] Residence | No. Bedrooms 3 |
| Pump Tank | (gal) | PT | | Date | | System Description: | 10" Large Diameter Pipe | | | [ ] Business | No. Persons 6 |
| Pump Make | | Model | | Serial # | | Repair System Description: | 50% Reduction | | | [ ] Other | No. Employees |
| # Nitrification Fields | 1 | # Lines | 5 | Linear Ft: | 720' | Maintenance Agreement Required: | [ ] YES | [X] NO | | [ ] Slab | [X] Crawl Space |
| Trench Width | 14" | Max. Trench Bottom Depth | 20" | Gravel Depth | N/A | [X] GRAVITY | [ ] PRESSURE | | | [ ] Basement w/plumbing | [ ] Basement w/o plumbing |


Water Supply: [ ] Private [X] Public [ ] Community

Comments / Conditions: Install 10" LDP on contour with Serial distribution. Must use 14" bucket or 1'ft bucket and dig remaining 2 inches.

INITIAL SITE SKETCH

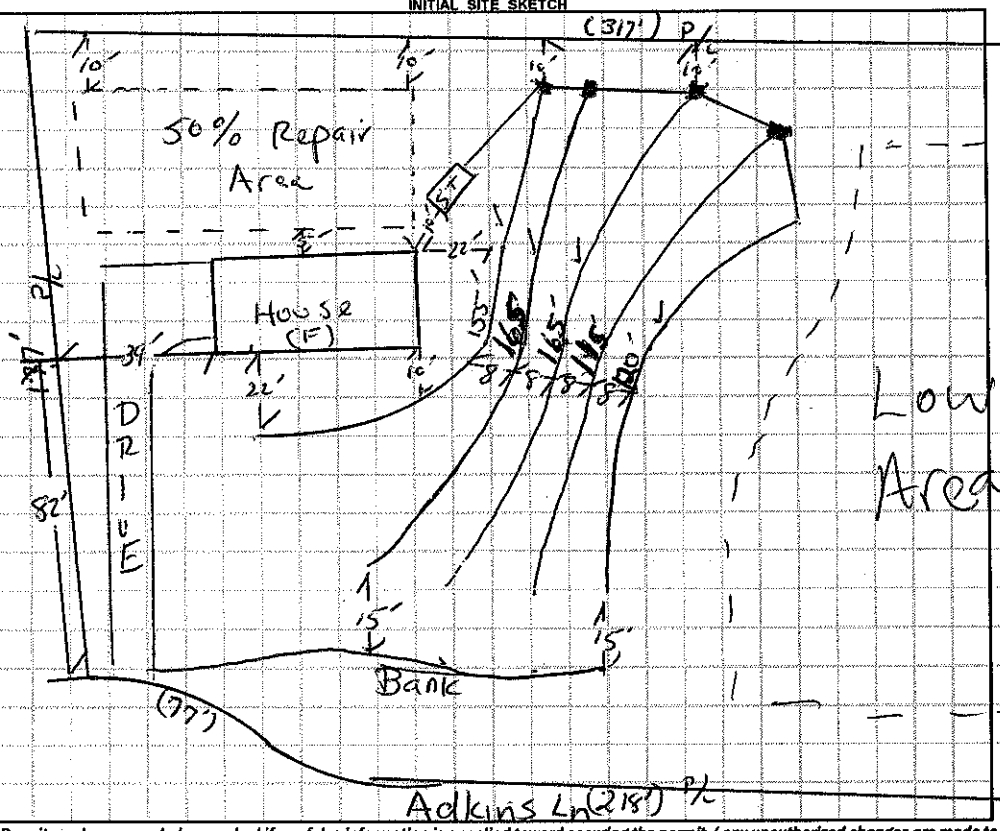


AS BUILT SKETCH

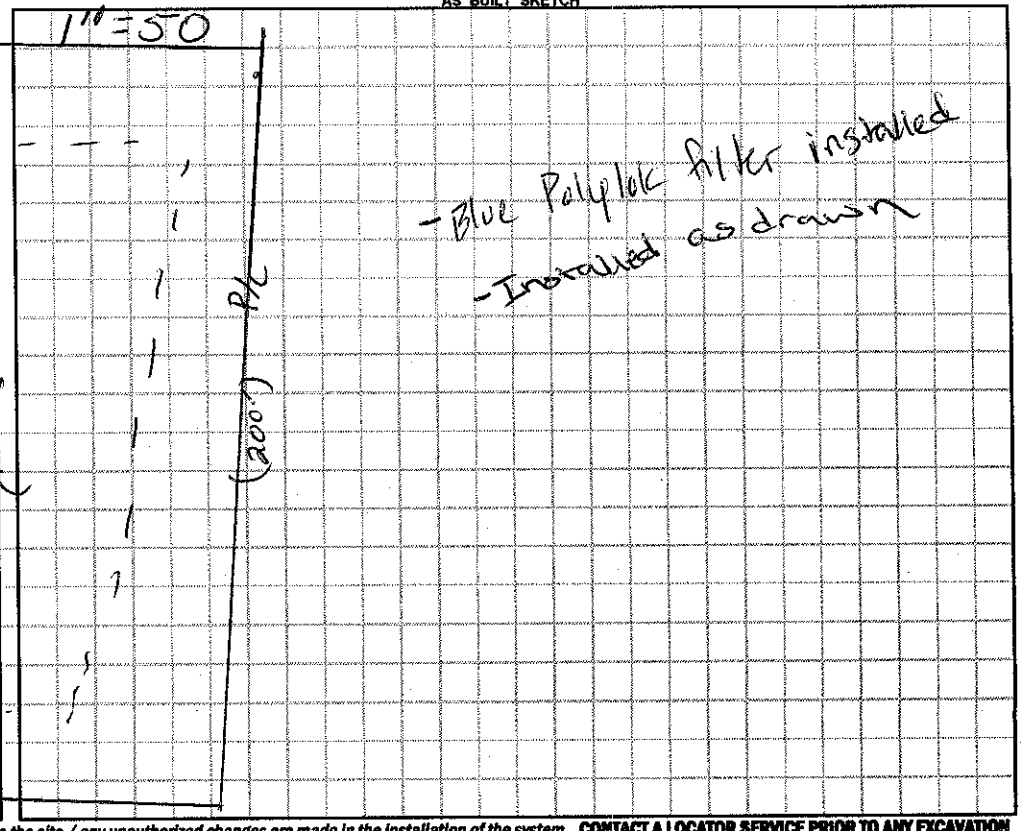


Permit can be suspended or revoked if any false information is supplied toward securing the permit / any unauthorized changes are made to the site / any unauthorized changes are made in the installation of the system. CONTACT A LOCATOR SERVICE PRIOR TO ANY EXCAVATION

[ ] IMPROVEMENT PERMIT with plat valid without expiration. [X] IMPROVEMENT PERMIT with site plan valid for 60 mos. [X] AUTHORIZATION TO CONSTRUCT valid for period equal to IMPROVEMENT PERMIT--not to exceed 60 mo.

Owner / Applicant Signature: Date: 8/7/14 Installed by: Jeff Bank + Son Clearing + Grading

IMPROVEMENT PERMIT by: Date: 08/06/14 OPERATION PERMIT by: Date: 11-25-14

AUTHORIZATION TO CONSTRUCT by: Date: 08/06/14 Existing System Inspected by: Date:

Health Dept. Copy - WHITE Applicant (Final Approval) - YELLOW Applicant (Conditional Approval) - PINK