9:1

IREDELL COUNTY HEALTH DEPARTMENT

STATESVILLE 704-878-5305 (at) MOORESVILLE 704-664-5281

IMPROVEMENT PERMIT / AUTHORIZATION TO CONSTRUCT / OPERATION PERMIT / EXISTING SYSTEM INSPECTION

PERMIT # 15744720 PIN # 4703-48-3635 1626 DATE 8-6-09

OWNER or APPLICANT Cindy & Ann Gettys PHONE: Business Cell Phone (704) 578-1116 Home (704) 878-7384

OWNER or APPLICANT ADDRESS 186 Hunter Pond Lane Statesville NC 28677

LOCATION / DIRECTIONS Hwy 70 West Exit on 144 (old Mountain Rd) to end of ramp) x140 R Cedar Church Rd TL Hunter... (Pond done at end of street)

SUBDIVISION Stonewood BLOCK / SECTION 2 LOT # 15B LOT AREA 0.65Ac DESIGN FLOW 360 L.T.A.R. 0.30 GPD/FT2

Septic Tank	1000	Gallons: STB	1012	Date	6-23-09	☑ New System ☐ Repair ☐ Expansion System Type I II (III) IV V VI	☑ Residence No. Bedrooms 3	Water Supply
Pump Tank		Gallons: PT		Date		System Description: 25% REDUCTION GRAVITY	☐ Business No. Persons	☐ Private
Pump Make		Model		Serial #		Repair System Description: 25% REDUCTION, PUMP	☐ Other No. Employees	☑ Public
Nitrification Field	No Fields 1	No Lines 2	Linear Feet 300			Maintenance Agreement Required ☐ YES ☑ NO	☐ Slab ☑ Crawl Space	☐ Community
Trench Width	36"	Max. Trench Bottom Depth	27"	Gravel Depth	N/A	☑ GRAVITY ☐ PRESSURE	☐ Basement w/plumbing ☐ Basement w/o plumbing	


Comments / Conditions: INSTALL 25% REDUCTION SYSTEM ON CONTOUR AS FLAGGED, NO DEEPER THAN 27 INCHES.

Comments / Conditions: Red Surf Site

Septic Marker

52' away from Pond

INITIAL SITE SKETCH

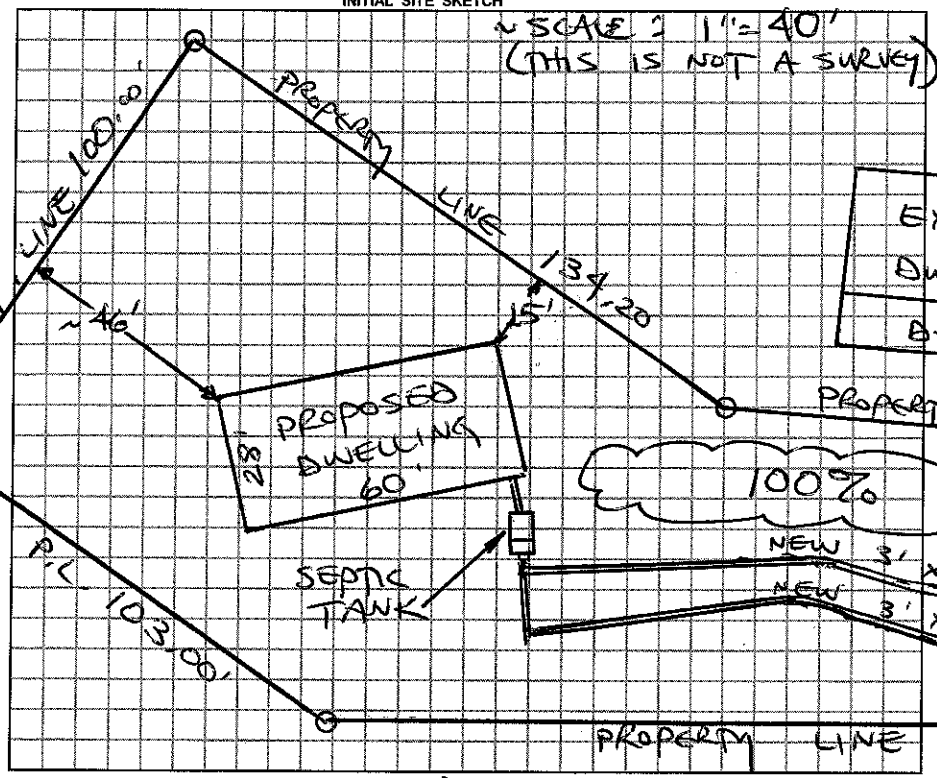

AS BUILT/SKETCH

Permit can be suspended or revoked if any false information is supplied toward securing the permit / any unauthorized changes are made to the site / any unauthorized changes are made in the installation of the system.

☐ *IMPROVEMENT PERMIT w / plat valid without expiration* ☑ *IMPROVEMENT PERMIT w / site plan valid for 60 mos.* ☑ *AUTHORIZATION TO CONSTRUCT valid for period equal to IMPROVEMENT PERMIT-not to exceed 60 mo.*

Owner / Applicant Signature: [signature] Date 8/7-09

Improvement Permit by: Fred Clemmer / Steve Hedrick RS Date 8/6/09

Authorization to Construct by: Fred Clemmer / Steve Hedrick RS Date 8-6-09

YOU SHOULD CONTACT A LOCATOR SERVICE PRIOR TO ANY EXCAVATION.

Installed by: Cindy Gettys

Operation Permit by: [signature] Date: 10-8-09

Existing System Inspected by: Date:

WHITE COPY Environmental Health YELLOW COPY (Final) Owner / Applicant PINK COPY (Initial) Owner / Applicant