IREDELL COUNTY HEALTH DEPARTMENT

STATESVILLE 704-878-5305 MOORESVILLE 704-664-5281

IMPROVEMENT PERMIT / AUTHORIZATION TO CONSTRUCT / OPERATION PERMIT / EXISTING SYSTEM INSPECTION

PERMIT# 100083 PIN# 4703 48 2635 DATE 5/4/01

OWNER OR CONTRACTOR Mark Gilpatrick PHONE: Business — Home (704) 878-6125

ADDRESS 130 Stewart Acres Dr Statesville NC 28677

LOCATION I-40 W, Exit 49 Mtn Rd (R) Bendale Rd turn left Mocksville Rd (L) Hunter Pond Rd at end.

SUBDIVISION Stonewood BLOCK / SECTION II LOT 15 LOT AREA 2.79 SITE CLASS PS DESIGN FLOW 360 L.T.A.R. .9

Septic Tank: 1,000 Gallons STB Date

Pump Tank: Gallons; PT Date

Pump Make: Model Serial No.

Nitrification Field: No Fields 1 Square Feet 900 Linear Feet 300

No Lines 4 Trench Width Existing Max Trench Bottom Depth Existing Gravel Depth 12"

☐ New System ☐ Repair System Type: I (II) III IV V VI

System Description: Existing Gravity, Conventional

Repair System Description:

Maintenance Agreement Required: ☐ Yes ☒ No

☐ House/Mod. Home ☒ Mobile Home ☐ Business ☐ Other

No. Bedrooms 3 No. Bathrooms 2 No. Employees

Water Supply: ☐ Individual ☒ Public ☐ Community


☐ Slab ☒ Crawl Space ☐ Basement w/plumbing ☐ Basement wo/plumbing

Comments:/Conditions:

Comments:/Conditions: System not in use at time of Inspection, but appears to have been working properly. Keep Home min 5ft from System; Keep Bldgs & Structures off Septic System area

INITIAL SITE SKETCH

AS BUILT SKETCH (Ref: Timothy Pope 5-9-91)

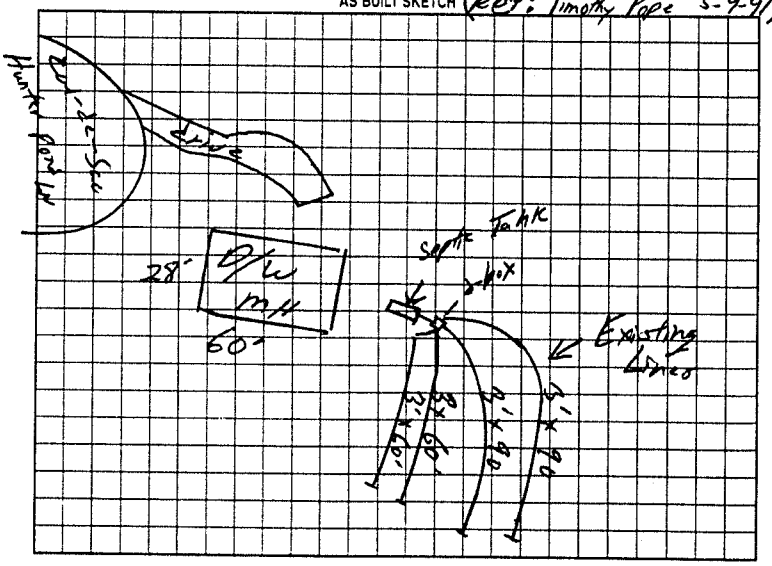

Permit can be suspended or revoked if any false information is supplied toward securing the permit/any unauthorized changes are made to the site/any unauthorized changes are made in the installation of the system. Improvement Permit with plat valid without expiration. Improvement Permit with site plan valid for sixty months. Authorization to Construct is valid for a period equal to that of Improvement Permit – not to exceed sixty months.

Signed: X Mark Gilpatrick date 5/4/91 Installed by:

Improvement Permit by: date Operation Permit by: date

Authorization to Construct by: date Existing System Inspection by: William O. Johnson RSI date 5/4/01

HEALTH DEPT. COPY WHITE OWNER COPY (FINAL) YELLOW OWNER COPY (INITIAL) PINK