IREDELL COUNTY HEALTH DEPARTMENT

STATESVILLE 704-878-5305 MOORESVILLE 704-664-5281

IMPROVEMENT PERMIT / CERTIFICATE OF COMPLETION / OPERATION PERMIT / EXISTING SYSTEM INSPECTION

PROPERTY DESCRIPTION NO. 17618 DATE 1-13-94 TAX MAP NO. 8M-7-A-21 Watershed: ☐ Yes ☑ No

OWNER OR CONTRACTOR Agnes Wooten (Olde Towne MH) PHONE: Business _____ Home 873-1481

ADDRESS 2016 N. Side Dr., Statesville, N.C. 28677

LOCATION I-40 W TL Old Mtn. Rd. TR Bewah Rd. Stay straight Mock Mill Rd. TL. Lot ≈ ½ mile on R.

SUBDIVISION Stonewood S/D BLOCK / SECTION — LOT 21 LOT AREA .260 X .90 SITE CLASS. P.S. DESIGN FLOW 240 L.T.A.R. .35 gpd/ft²

Septic Tank: 1000 Gallons; STB 358 Date 12-1-93
Pump Tank: — Gallons; PT — Date —
Pump Make: — Model — Serial No. —
Nitrification Field: No Fields 1 Square Feet 690 Linear Feet 230'
No Lines 3 Trench Width 36" Max Trench Bottom Depth 26"


☑ New System ☐ Repair System Type: I, II, III, IV, V, VI
System Description: conventional; gravity fed.
Repair System Description: "
Maintenance Agreement Required: ☐ Yes ☑ No
Gravel Depth 12"

☑ House/Mod. Home No. Bedrooms 2
☐ Mobile Home No. Bathrooms 1
☐ Business No. Employees —
☐ Other
☐ Slab ☑ Crawl Space ☐ Basement w/plumbing ☐ Basement wo/plumbing

Water Supply:
☐ Individual
☐ Community
☑ Public

Comments: Saprolite reclassified. Install SYSTEM SHALLOW (no deeper than 26" to bottom of trench.) Keep Nitrification lines on contour. Keep system 10' from all property lines, 5' from foundation of home, and 10' from water line. 100% Repair Area above and below system (conventional), gravity fed.)

INITIAL SITE SKETCH

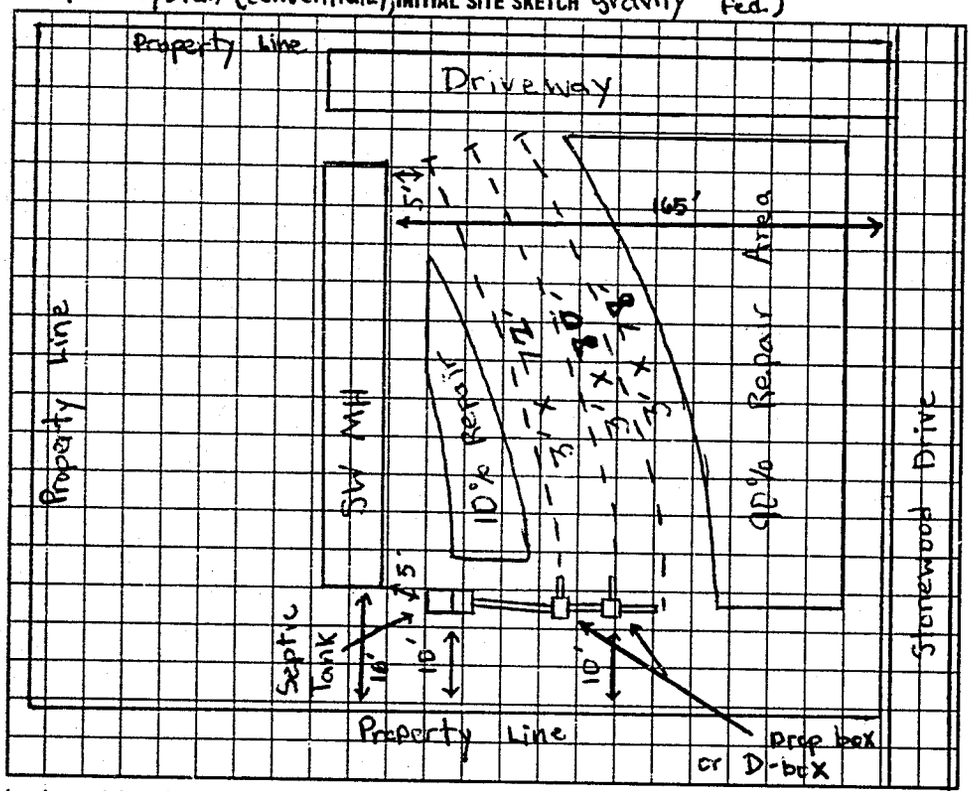

Comments: Driveway not installed where permitted - DO NOT LOCATE DRIVEWAY OVER ANY PART OF SEPTIC SYSTEM. Home on site at time of final, water line not installed at time of inspection, keep water line 10' from any part of Septic system. 100% Repair Area, partially above and the remainder below initial system, conventional, gravity fed.

AS BUILT SKETCH

SAME AS INITIAL SKETCH

I understand that this permit can be suspended or revoked if any false information is supplied toward securing the permit/any unauthorized changes are made to the site/any unauthorized changes are made in the installation of the system. Improvement Permit is valid for 60 months from date of issuance.

Signed: [signature]

Improvement Permit by: Michael J. Dennis date 1-13-94

Existing System Inspection by: _____ date _____

Installed by: A-1 Backhoe

Certificate of Completion by: Michael J. Dennis date 2-3-94

Operation Permit by: _____ date _____

HEALTH DEPT. COPY: WHITE INSPECTION COPY (FINAL): GREEN OWNER COPY (FINAL): YELLOW INSPECTION COPY (INITIAL): PINK OWNER COPY (INITIAL): GOLD