IREDELL COUNTY HEALTH DEPARTMENT

STATESVILLE 704-878-5305 ✓ MOORESVILLE 704-664-5281

IMPROVEMENT PERMIT / AUTHORIZATION TO CONSTRUCT / OPERATION PERMIT / EXISTING SYSTEM INSPECTION

PERMIT# 10882 PIN# 4703-49-4520 DATE 8-27-01

OWNER OR CONTRACTOR DEANNA PEARSON PHONE: Business Home (336) 869-8480

ADDRESS 3910-37 N. MAIN ST, HIGH POINT, NC 27265

LOCATION I-40 W TL OLD MTN. RD, TR BEULAH RD, CONTINUE MOCK MILL RD, TL HUNTER POND LN, Lot# 11 on LEFT.

SUBDIVISION STONEWOOD BLOCK / SECTION II LOT 11 LOT AREA 0.5865 ACRE SITE CLASS PS DESIGN FLOW 240 L.T.A.R. 0.30 GPD/FT²

Septic Tank: 1000 Gallons: STB 1012 Date 9-1-01
Pump Tank: 1000 Gallons: PT 17 Date 8-24-01
Pump Make: Hydromatic Model SHEF50A1 Serial No. 5186-09-7
Nitrification Field: No Fields 1 Square Feet 810 Linear Feet 270'
No Lines FOUR Trench Width 36" Max Trench Bottom Depth 36" Gravel Depth 12"

☑ New System ☐ Repair System Type: I II III IV V VI
System Description: CONVENTIONAL PUMP
Repair System Description: 50% REDUCTION, GRAV.
Maintenance Agreement Required: ☐ Yes ☑ No


☐ House/Mod. Home No. Bedrooms 2
☑ Mobile Home No. Bathrooms 2
☐ Business No. Employees
☐ Other
☐ Slab ☑ Crawl Space ☐ Basement w/plumbing ☐ Basement wo/plumbing

Water Supply: ☐ Individual ☑ Public ☐ Community

Comments/Conditions: SEE ATTACHED SHEETS FOR PUMP AND PRESSURE MANIFOLD REQUIREMENTS

Comments/Conditions: -Polylok Filter Installed
-Sipahi Tank Riser Installed
-Pressure Check 11/06/01 okay
-Alarm Electrical Check okay 11/19/01

INITIAL SITE SKETCH

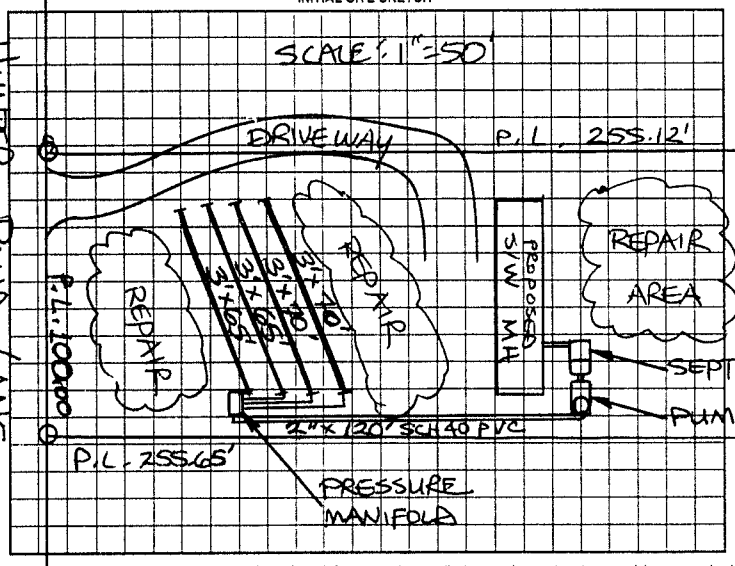

AS BUILT SKETCH

Installed as Shown per Initial Site Sketch

Permit can be suspended or revoked if any false information is supplied toward securing the permit/any unauthorized changes are made to the site/any unauthorized changes are made in the installation of the system. Improvement Permit with plat valid without expiration. Improvement Permit with site plan valid for sixty months. Authorization to Construct is valid for a period equal to that of Improvement Permit – not to exceed sixty months.

Signed: [signature] date 8-27-01 Installed by: A-1 Backhoe

Improvement Permit by: STEVE HEDRICK date 8-27-01 Operation Permit by: William O. Johnson date 11/19/01

Authorization to Construct by: STEVE HEDRICK date 8-27-01 Existing System Inspection by: date

HEALTH DEPT. COPY WHITE OWNER COPY (FINAL) YELLOW OWNER COPY (INITIAL) PINK