IREDELL COUNTY HEALTH DEPARTMENT

STATESVILLE 704-878-5305 MOORESVILLE 704-664-5281

IMPROVEMENT PERMIT / CERTIFICATE OF COMPLETION / OPERATION PERMIT / EXISTING SYSTEM INSPECTION

#L 64637

PROPERTY DESCRIPTION NO. 25558 DATE 11-27-96 TAX MAP NO. 8M-7-A-10 Watershed: ☐ Yes ☒ No

OWNER OR CONTRACTOR TEDDY HENSLEY, JR PHONE: Business Home 873-1481

ADDRESS c/o OLDE TOWNE MH, 2016 NORTHSIDE DR, STATESVILLE, NC 28677

LOCATION MOCK MILL ROAD, TI HUNTER POND LANE, 5TH LOT ON LEFT

SUBDIVISION STONEWOOD BLOCK / SECTION LOT 10 LOT AREA SITE CLASS. PS DESIGN FLOW 360 L.T.A.R. EXISTING

Septic Tank: 1000 Gallons; STB Date

Pump Tank: Gallons; PT Date

Pump Make: Model Serial No.

Nitrification Field: No Fields 1 Square Feet 300 Linear Feet 100

No Lines 1 Trench Width 36" Max Trench Bottom Depth 24 Gravel Depth 12"

☒ New System ☐ Repair System Type: I, II, III, IV, V, VI

System Description: CONVENTIONAL GRAVITY

Repair System Description: CONV. PUMP (GAS)

Maintenance Agreement Required: ☐ Yes ☒ No

☐ Slab ☒ Crawl Space ☐ Basement w/plumbing ☐ Basement w/o plumbing

☐ House/Mod. Home ☒ Mobile Home ☐ Business ☐ Other


No. Bedrooms 3 No. Bathrooms 2½ No. Employees

Water Supply: ☐ Individual ☐ Community ☒ Public

Comments: INSTALL NEW DIST BOX & 3'X100' LINE ON CONTOUR AS FLAGGED ON SITE

Comments:

INITIAL SITE SKETCH

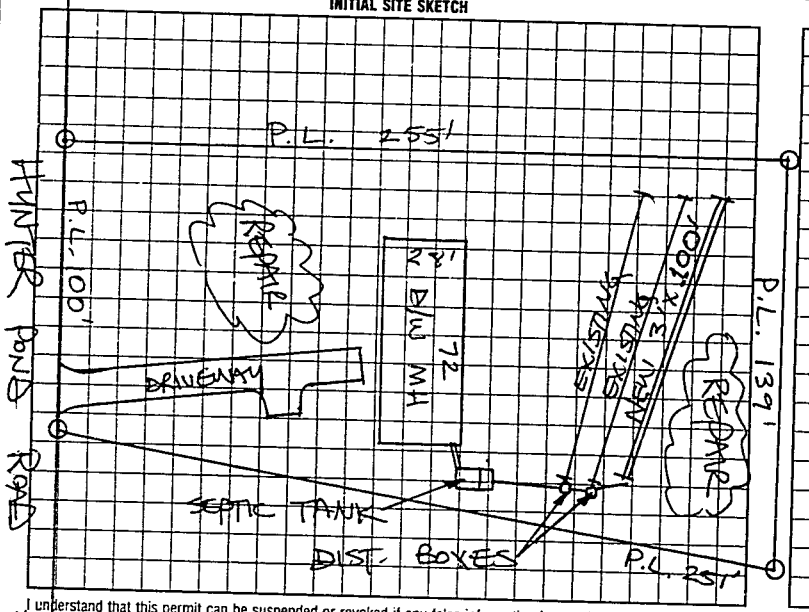

AS BUILT SKETCH

SYSTEM INSTALLED TO ACCOMODATE 3BR MH ACCORDING TO INITIAL SITE SKETCH

I understand that this permit can be suspended or revoked if any false information is supplied toward securing the permit/any unauthorized changes are made to the site/any unauthorized changes are made in the installation of the system. Auth. to Const. is valid for a period equal to the validity of the IP not to exceed five years. IP w/site plan is valid five years.

Signed: T. E. H. Hall

Improvement Permit by: STEVE HEDRICK date 11-27-96

Authorization to Construct by: STEVE HEDRICK date 11-27-96

Installed by: A-1 BACKHOE

Certificate of Completion by: date

Operation Permit by: STEVE HEDRICK date 12-12-96

HEALTH DEPT COPY: WHITE INSPECTION COPY (FINAL): GREEN OWNER COPY (FINAL): YELLOW INSPECTION COPY (INITIAL): PINK OWNER COPY (INITIAL): GOLD